


SURVEY

Bert Sims
 Partion Secs. 2 and 11
 T. 36 S. R. 1 W. W. M.
 Jackson County, Oregon.
 Scale 1" = 400' Horizontal.
 Sept. 1957 Civil Engineer

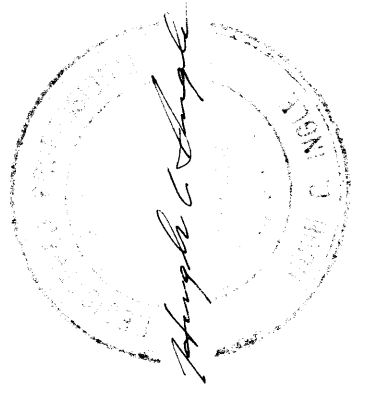

NARRATIVE REPORTSurvey ForBert Sims

in

Sec. 11, T. 36 S. R. 1 W., W. M.
 Jackson County,
 Oregon.

Purpose of Survey

To establish lines and corners for a 5 Acre parcel of Sims property in the southwest corner thereof.

Procedure.

Found concrete monuments with brass caps at the North and the South corners on the west line of property and also at the Southeast corner of the Northeast quarter of the northwest quarter of Section 11.

Ran on lines between corners North to southerly boundary of pipe line R/W of Record and along said line. Also East from southwest property corner the distance required to mark off 5 Acres.

