

Survey No. _____

Paul Rynning
County Surveyor
Madford, Oregon

Subject: Restoration of obliterated corner.

Township 34 South, Range 1 East, Willamette Meridian

Section Corners, 11, 12, 13 and 14.


Found rock mound, set wood stake
Found B.Oak scribe rotted away N.30°W., 113 lbs.
Found remains B.Oak S.17°W., 118 lbs., and small portion of scribe NT
Found stump of B.Oak stump hole N.31°E., 97 lbs.

Double blazed (no scribe) Yellow Pine 16 ins. diam., N.16°E., 9.2 lbs.
Double blazed (no scribe) Sugar Pine 6 ins. diam., S.17°W., 33.0 lbs.

Quarter corners 11 and 12.

Found rock mound, set stake.
Found Yellow Pine original NT, now a fallen snag, scribe 1/4 S
visible, S.42°E., 220 lbs.

A Yellow Pine 14 ins. diam., bears S.77°E., 25½ lbs. scribed 301 NT.
A Yellow Pine 8 ins. diam., bears S.21°W., 75½ lbs., scribed 301 NT.

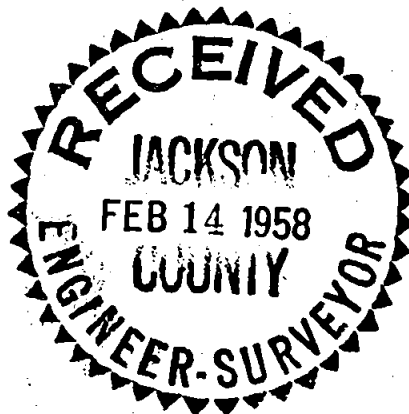

Edward A. McGinty

