

10891

Page 2

On the bearing tree in Section 16 I placed a brass washer marked PLS 382 with an aluminum nail at the base of the healed scar and painted a 4 inch wide red band around the tree at approximately eye height and painted BT on the upslope and downslope sides.

On the stump of the severed bearing tree I placed a brass washer marked PLS 382 at the base of the healed scar with an aluminum nail and painted BT on the downslope side.

I hereby certify the subject corner and its accessories was perpetuated as hereon described on May 29, 1987.


Office of Surveyor, County of Jackson
State of Oregon, I hereby certify that
the within instrument was filed in this
office for the record on the 3rd day of
June 1987.

By: Sharon A. Katzendach title Secretary

REGISTERED
PROFESSIONAL
LAND SURVEYOR

Paul E. Lauch

OREGON
MAY 4, 1956
PAUL E. LAUCH
382

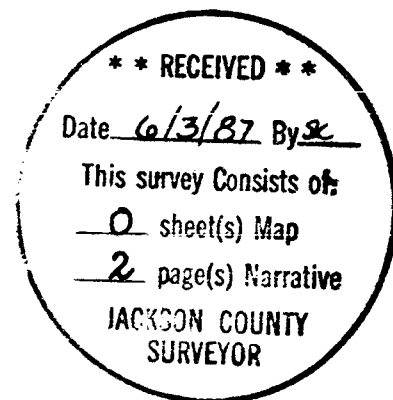

10891

CERTIFIED RECORD OF LAND CORNER MONUMENTATION

History of original corner establishment: Original corner established in 1917 by Marshall S. Wright: Set iron post with brass cap marked T39S. R2W. S9, S16. From which:
A fir bears S82 3/4° W 51 links
A fir bears N 60 1/2° W 46 links

Diagram

T39S	
S9	
S16	
R2W	

In 1957, at the request of the Medford BLM District, this corner was remonumented. Found were a decayed fir stump which bears S82 3/4° W 51 links and a 19 inch fir which bears N 60 1/2° W 46 links. Marked a new bearing tree - An 8 inch diameter fir bears S 34° W 58 links marked T 39 S R 2 W S16 BT.

In 1974, as a result of road construction near this corner the bearing tree in the northwest quadrant was destroyed, a new bearing tree was marked by Graham & Frederick - A Douglas-fir 13 inches in diameter bears S 88 1/2° W 25.5 feet marked CS BT (no tree available in N W quadrant)

Description of corner evidence found: Original pipe post and brass cap was found in a downslope leaning position but otherwise as originally described. From which:
A 10 inch diameter Douglas-fir bears S35°W 38.8 feet with healed scar facing the corner, and Department of Interior BLM S-9 Bearing tree poster marked T 39 S, R2W, Sec. 16 "Corner is N 34° E 58 links."

A 16 inch diameter newly cut Douglas-fir stump with a red painted "X" cut across the top with a chain saw bears S 89° W 25.4 feet. Stump has a healed over scar on the east side near the ground line encircled with red paint.

Description of monument and accessories established to perpetuate the original location of this corner: Due to the close proximity of the pipe post to the excavated roadway slope I made no attempt to place it in an upright position. In order that the corner may have a minimum of two live bearing trees and there being no close trees in Section 9 which to mark, I marked a 17 inch diameter Douglas-fir in Section 15 which bears S 41° E 46.1 feet distance and scribed T39 S R2W S15 BT and placed a brass washer marked PLS 382 with an aluminum nail at the base of the scribed blaze. I also painted a 4 inch wide red band around the tree at approximately eye height and painted red BT on the upslope and downslope sides.