
Map of Survey

Located in the southwest quarter of Section 16, Township 34 South, Range 2 West of the Willamette Meridian, Jackson County, Oregon.

for

BOISE CASCADE CORPORATION

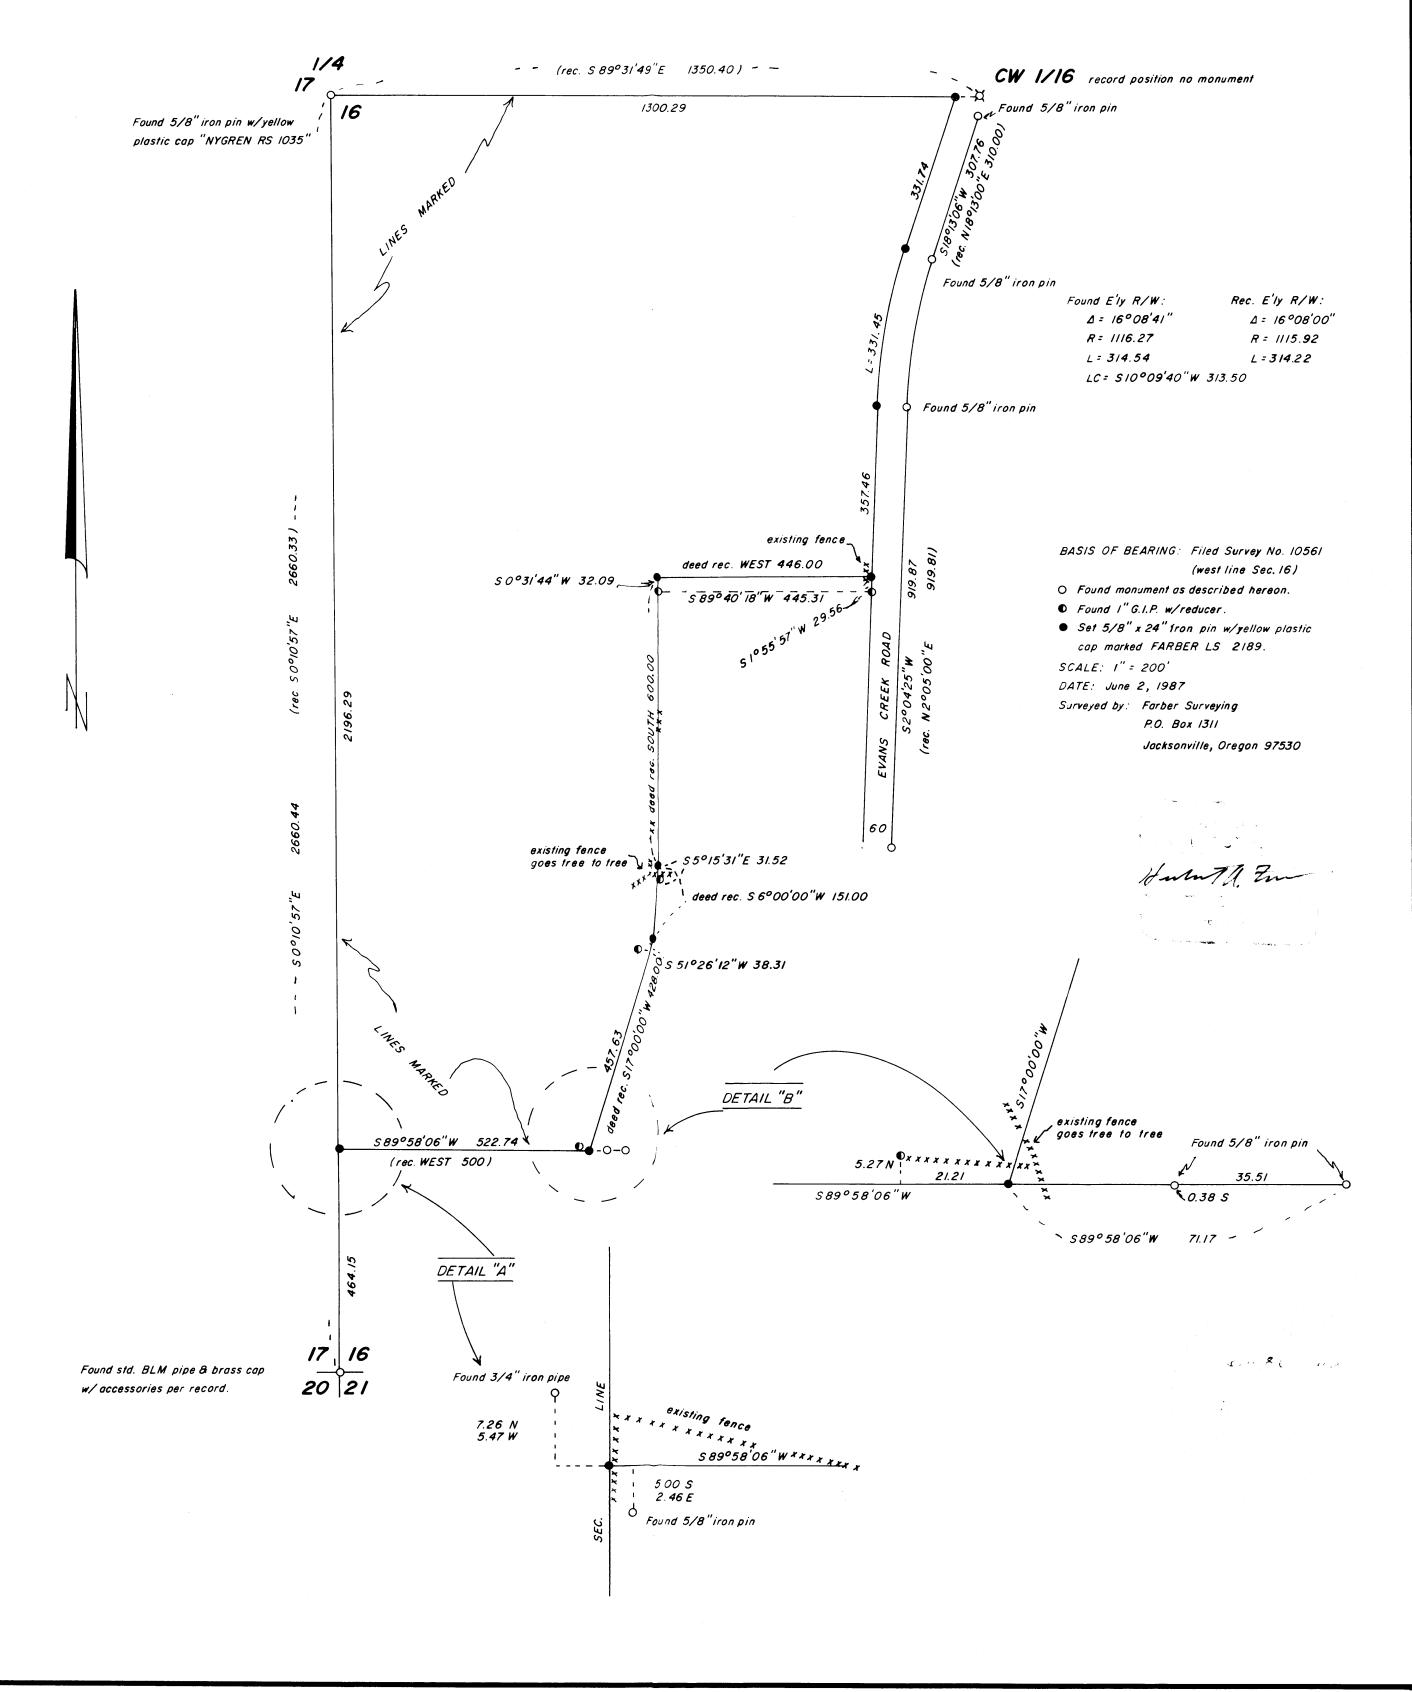

NARRATIVE TO COMPLY WITH O.R.S. 209.250.

Survey for:

Boise Cascade Corporation

P.O. Box 100

Medford, Oregon 97501

Location:

Located in the southwest quarter of Section 16, Township 34 South, Range 2 West of the Willamette Meridian,

Jackson County, Oregon.

Purpose:

To monument and mark the lines of tract "B" as shown on the accompanying map as described in Volume 595, Page 300 of Deed

Records of Jackson County.

Procedure:

The controlling corners and deed lines and all found monuments where incorporated in a closed traverse. This section was recently subdivided by Gerald Nygren at which time he established the west and east quarter corners as shown on filed survey no. 10561. The deed for the tract being surveyed begins at the northeast corner of the northwest quarter of the southwest quarter. The position of several found monuments, of unknown origin, would be relatively close if this corner was 30 feet to the south of its actual position. It is obvious to me that an attempt was made to monument this tract without the subdivision of the section. I therefor monumented the tract holding the westerly right of way line of Evans Creek Road as a physical monument, from which I used record deed bearings and distances to the north line of Volume 172, Page 475 of the Deed Records of Jackson County.

I used filed survey no. 10561 for the subdivision lines of the section and based my bearing on the west line of the southwest quarter.

Surveyed By:

Farber Surveying P.O. Box 1311

Jacksonville, Oregon 97530

Date:

June 2, 1987

REGISTERED
PROFESSIONAL
LAND SURVEYOR

OREGON
ANY 26. 1985
HERBERT A. FARBER

* * RECEIVED * *

Date 6/11/87 By SK

This survey Consists of:

______ sheet(s) Map

____ page(s) Narrative

JACKSON COUNTY SURVEYOR