


# PLAT

SHOWING A SURVEY IN SEC.  
5, T.35S., R.2W., W.M., JACKSON  
COUNTY, OREGON.

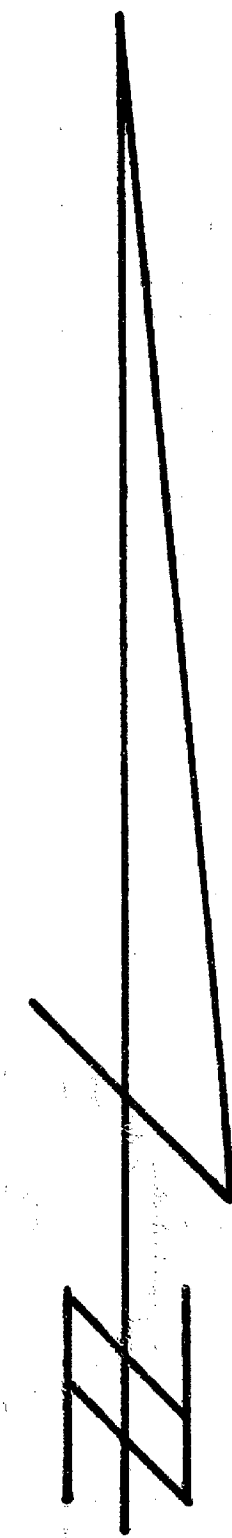

### LEGEND

- SET 5/8" X 30" IRON ROD WITH PLASTIC CAP MARKED "NYGREN LS1035."
- FOUND IRON MONUMENT AS NOTED.
- ⊙ FOUND BRASS CAP AS NOTED.
- //// BLAZED AND TAGGED LINE.

NOTE: BEARINGS BASED ON THE NORTH-SOUTH CENTERLINE OF SEC. 5 PER SUR. NO. 3857.

SURVEY NARRATIVE SEPERATE DOCUMENT.

REGISTERED  
PROFESSIONAL  
LAND SURVEYOR  
*Gerald V. Nygren*  
OREGON  
GERALD V. NYGREN  
AUGUST 22, 1975  
1035

\*\* RECEIVED \*\*  
Date 6/9/87 By JK  
This survey consists of:  
— sheet(s) Map  
— page(s) Narrative  
JACKSON COUNTY  
SURVEYOR

SURVEYED FOR: BOISE CASCADE CORR P. O. BOX 100 MEDFORD, OREGON 97501	<b>GERALD V. NYGREN</b> 522 BARKER DRIVE MERLIN, OREGON 97532	DATE: JUNE 6, 1987. SCALE: 1" = 400' JOB NO. 87-19
---	---	--

10898

SURVEY NARRATIVE to comply with ORS 209-250.

DATE: June 6, 1987.

SURVEYED FOR: Boise Cascade Corp.  
P.O. Box 100  
Medford, Oregon 97501

SURVEYED BY: Gerald V. Nygren  
522 Barker Drive  
Merlin, Oregon 97532

LOCATION: Section 5, Township 35 South, Range 2 West, Willamette  
Meridian, Jackson County, Oregon.

PURPOSE: To subdivide said Section 5, set the East one-sixteenth  
on the North line, the Center Quarter corner, the  
Center North one-sixteenth corner and the Center South  
one-sixteenth corner. Mark the line from the Center  
North one-sixteenth corner to the North one-sixteenth  
corner on the East line of said Section 5 and also  
mark the line from the North one-sixteenth corner on  
the East line of said Section 5 to the approximate  
South one-sixteenth corner on the East line of said  
Section 5.

PROCEDURE: Using monuments shown as found on Plat I subdivided  
said Section 5 and set monuments as shown on Plat.

Bearings based on the North-South centerline of Section  
5 per Survey No. 3857.

A wild T-16 theodolite and MAC-1E EDM were used to  
execute this survey.

