



10906

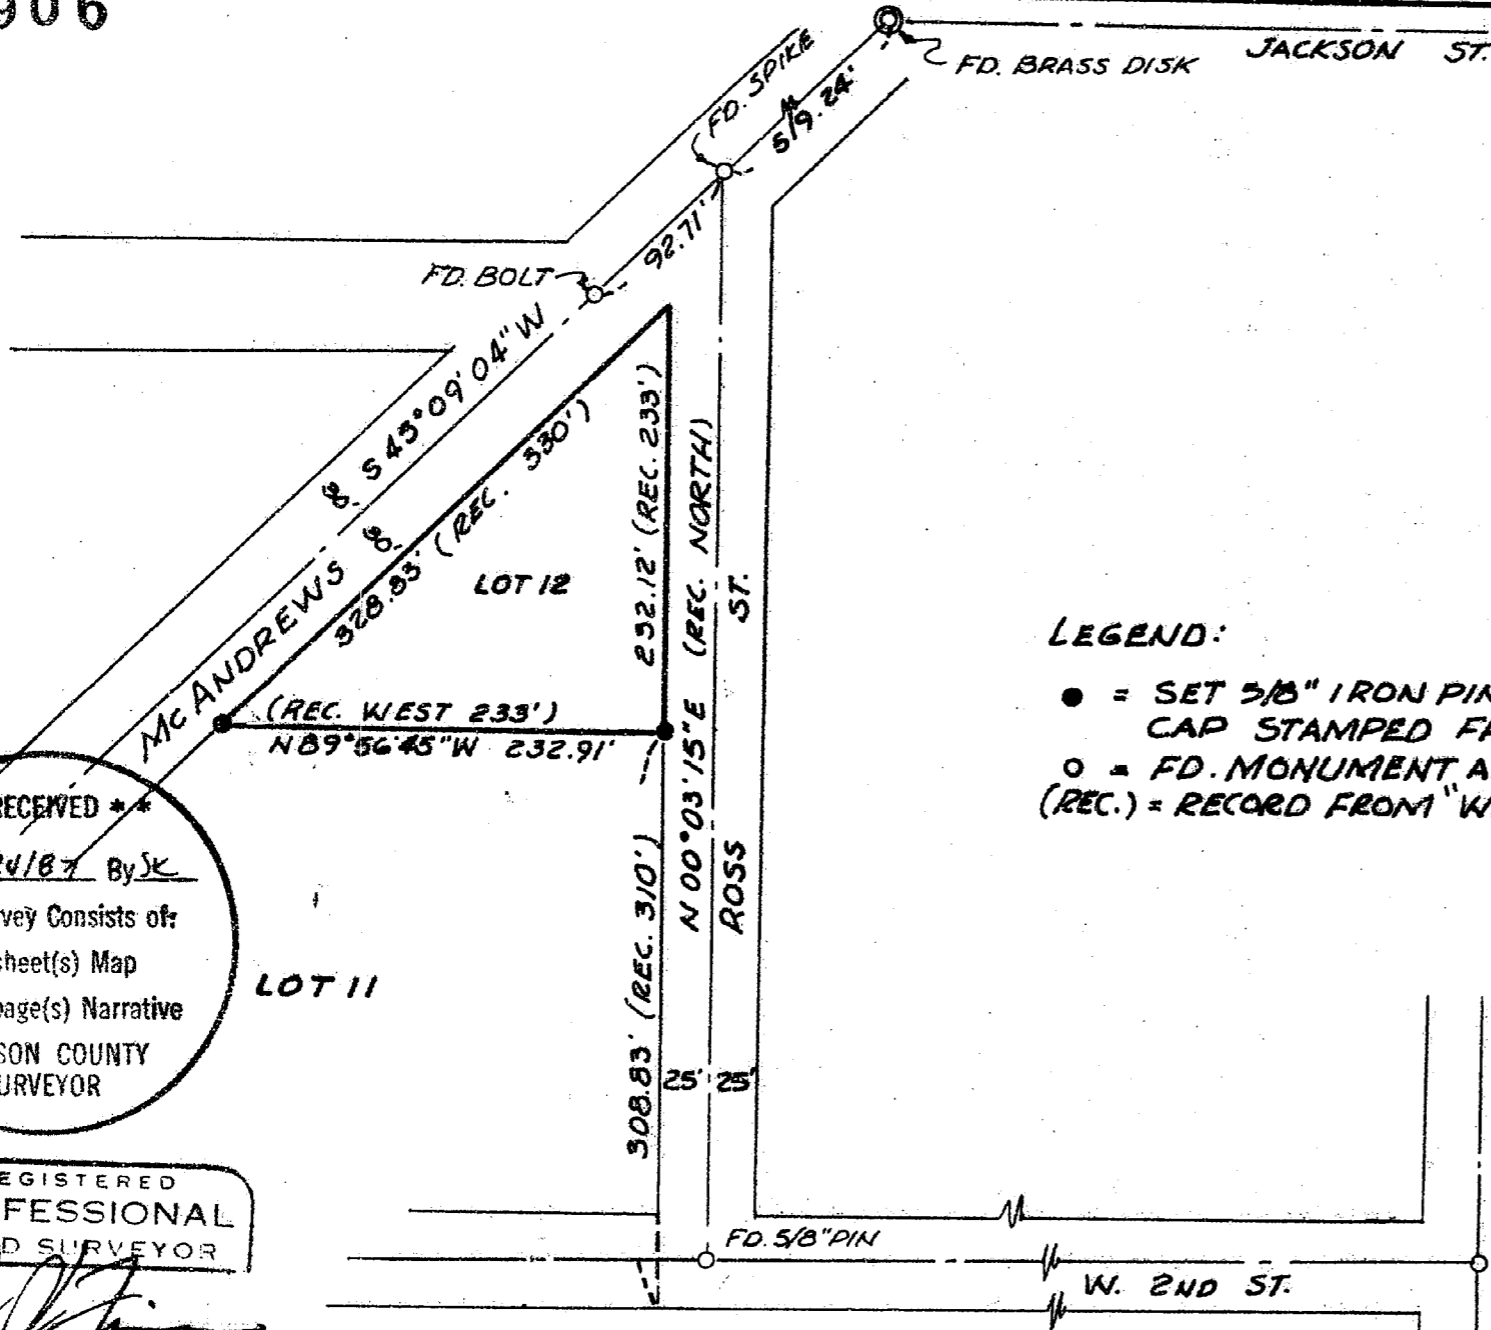

LEGEND:

- = SET 5/8" IRON PIN WITH PLASTIC CAP STAMPED FRIAR PLS 961
- = FD. MONUMENT AS SHOWN
- (REC.) = RECORD FROM "WEST MEDFORD" SUBD.

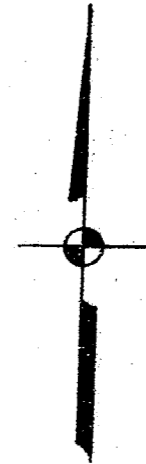

**\*\* RECEIVED \*\***  
 Date 6/24/87 By JK  
 This survey consists of:  
 / sheet(s) Map  
 / page(s) Narrative  
 JACKSON COUNTY SURVEYOR

REGISTERED PROFESSIONAL LAND SURVEYOR

*Larry J. Friar*  
 OREGON JULY 16, 1971 LARRY J. FRIAR 961

MAP OF SURVEY FOR PHILLIP CROCKER

BEING LOT 12, BLOCK 3, 'WEST MEDFORD' SUBDIVISION. IN THE N.W. 1/4 OF SECTION 25, T.37S., R. 2 W., W.M., JACKSON CO. OREGON.

SCALE: 1"=100' DATE: JULY, 1985  
 BASIS OF BEARING: SURVEY NO. 6223

10906

Survey No. 10906

Survey narrative to comply with O.R.S. 209.250

Survey for: Philip Crocker  
1059 W. McAndrews  
Medford, Or 97501

Location: Lot 11, Block 3, West Medford in the  
N.W. 1/4 Sec. 25, T.37 S., R.2 W.,  
W.M., Jackson County., Oregon.

Purpose: To monument lot line between lots  
11 & 12, Block 3, "West Medford"  
Subdivision.

Procedure: Established lot line at proportionate  
distance and at record angle from  
control on Ross Street established  
previously during an extensive control  
survey for a sanitary sewer project.

Date: July 11, 1985

Larry J. Friar  
Friar-Moffit & Assoc.  
717 W. 10th St.  
Medford, Or 97501

