

SURVEY NO. 10913

SURVEY NARATIVE TO COMPLY WITH PARAGRAPH 209.250, OREGON REVISED STATUTES.

SURVEY FOR: Ed Carte
Foots Creek Road
Gold Hill, Oregon

LOCATION: The North 1/2 of Section 2, Township 37 South,
Range 4 West of the Willamette Meridian,
Jackson County, Oregon.

PURPOSE: Set property corners and flag property lines
per Leed Records as shown on the accompanying
plat.

PROCEDURE: Traversed from the West 1/4 corner to the
East 1/4 corner of Section 2. Traverse
perimeter of the subject property and made
ties to County Road monuments. Calculated
position of property corners to be set.
Set 5/8 inch by 24 inch steel pins with
yellow plastic caps stamped "D.W. EDWARDS-
LS 741".

BASIS OF BEARINGS: Recorded Survey Number 9937.


DATE COMPLETEL: May 29, 1987.

SURVEY BY: Darrel W. Edwards
2000 Brookhurst #27
Medford, Oregon 97504
phone 776-2313

REGISTERED
PROFESSIONAL
LAND SURVEYOR

Darrel W. Edwards

OREGON
JULY 8, 1966
DARREL W. EDWARDS
741

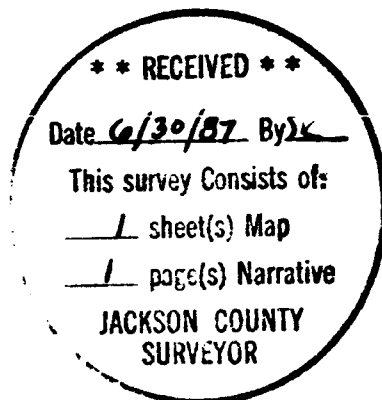

T. 37 - 4 W., Sec. 2, T.L. 1700