

10922

SURVEY NARRATIVE TO COMPLY WITH
PARAGRAPH 209.250 OREGON REVISED STATUTES

SURVEY FOR: Rogue River National Forest
P. O. Box 520
Medford, OR 97501

LOCATION: Section 26, Township 31 South, Range 3 East,
Willamette Meridian, Jackson County, Oregon.

PURPOSE: To preserve and protect deteriorating corner
evidence.

PROCEDURE: Utilizing existing corner evidence recovered at
the corner point, I verified the corner point from
recovered accessories and stabilized the monument
as needed.

BASIS OF BEARING: Compass Bearing (var. 19°30'E)

DATE: June 12, 1987

HAROLD L. CENTER
Registered Professional Land Surveyor
Oregon Certificate No. 1071

REGISTERED
PROFESSIONAL
LAND SURVEYOR


Harold L. Center
OREGON
HAROLD L. CENTER
JULY 20, 1976
No. 1071

** RECEIVED **
Date 7/6/87 By SL
This survey consists of:
0 sheet(s) Map
2 page(s) Narrative
JACKSON COUNTY
SURVEYOR

CERTIFIED RECORD OF LAND CORNER MONUMENTATION

History of original corner establishment:

The section corner for Sections 23, 24, 25, and 26, Township 31 South, Range 3 East, Willamette Meridian, Jackson County, Oregon, was originally established by Peter Applegate under contract No. 571, dated April 10, 1891.

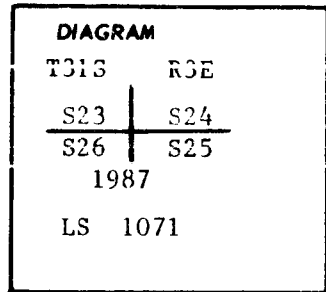

Description of corner evidence found:

No monument was found. The four original bearing trees, as described by Applegate were recovered:

- A 36-inch diameter cedar bears record N.22°E., 27.1 feet distance, to an open face with fragmentary scribing visible.
- A 60-inch diameter pine snag, rotted and without bark, bears record S.11°E., 11.2 feet distance to a burnt face.
- A 66-inch diameter fir bears record S.55°W., 14.2 feet distance to the center-side, with a healed blaze.
- A 52-inch diameter fir bears record N.25°W., 14.2 feet distance to the center-side, with a healed blaze.

Description of monument and accessories I established to perpetuate the original location of this corner

At the corner point, as determined by the record distance - distance intersection of the original bearing trees (cedar and pine), I set a 2 1/2-inch diameter iron post 26 inches in the ground and built a small mound of stone around monument, marked as shown in diagram.

June 12, 1987

HAROLD L. CENTER
Registered Professional Land Surveyor
Oregon Certificate No. 1071



Office of..... County of.....
 State of....., I hereby certify that the within instrument was filed in this office
 for record on the day of; 19....., at..... o'clockm., (signed)
 by
 (COUNTY OFFICIAL) (DEPUTY)

