


FD. 1" I. PIN
 N.E. CORNER S. 112
 D.L.C. NO. 42
 PER VOL 10 PAGE 127 D.R.

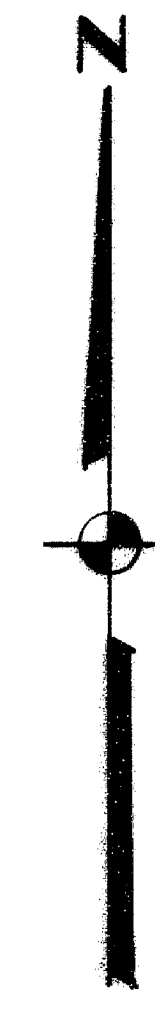

LEGEND:
 ● = SET 5/8" IRON PIN WITH PLASTIC CAP MKD
 FRIAR P.L.S. 961
 ○ = FOUND MONUMENT AS SHOWN
 D.R. = OFFICIAL DEED RECORD
 PK = PARKER - KALON MASONRY NAIL
 (REC) = RECORD

MAP OF SURVEY

JACKSON COUNTY DEPT. OF PARKS & RECREATION

LOCATED IN DONATION LAND CLAIM NO. 42, TOWNSHIP 38 SOUTH, RANGE 1 WEST, WILLAMETTE MERIDIAN, JACKSON COUNTY, OREGON.
 DATE: JULY, 1987

BASIS OF BEARING: SURVEY NO. 4918
 SURVEY BY: L. J. FRIAR & ASSOCIATES
 MEDFORD, OREGON.

SCALE: 1" = 100'

T. 38 S., R. 1 W., SEC. 10 T. L. 3402

REGISTERED
PROFESSIONAL
 LAND SURVEYOR
 LARRY J. FRIAR
 961

** RECEIVED **
 Date 10/27/87 By SC
 This survey consists of
 1 sheet(s) Map
 1 page(s) Narrative
 JACKSON COUNTY
 SURVEYOR

Survey No. 11016

Survey Narrative to Comply with O.R.S. 209.250

SURVEY FOR: Jackson County Department of
Parks & Recreation
Court House
Medford, Oregon 97501

LOCATION: Donation Land Claim No. 42,
T. 38 S., R.1 W., Willamette Meridian,
Jackson County Oregon.

PURPOSE: To determine boundaries of a strip
of land extending Northeasterly from
the Easterly line of Pacific Highway
No. 99 to Bear Creek for the Bear Creek
Greenway Project.


PROCEDURE: Recovered and tied in monument set
by previous surveys, as shown on the
Annexed map, for control, and established
the lines of the tract per Deed descriptions.

The found P-K nails on the centerline of
Highway 99 as shown were used for control
rather than the Right of Way pins which
have been disturbed.

Monuments found and set are as shown on
the Annexed map.

T 38 S., R.1 W., DLC# 42

October 26, 1987

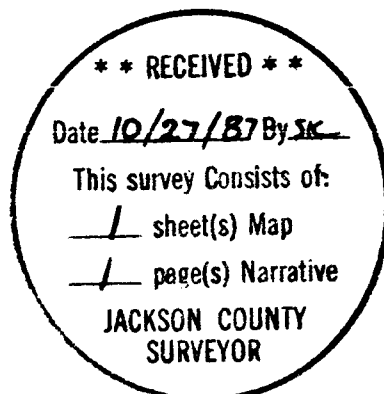

Larry J. Friar
L.J. FRIAR & ASSOCIATES
717 West Tenth # 1
Medford, Oregon 97501

