
SURVEYOR Veriyn Thomas 304 South Holly Medford, Oregon

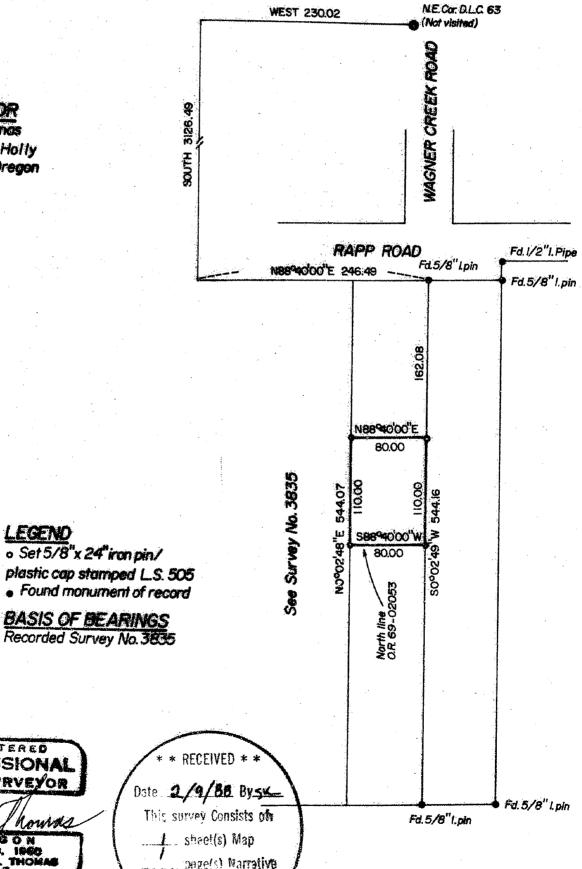

REGISTERED

LAND SURVEYOR

LEGEND

o Set 5/8"x 24" iron pin/

PRESON
MAY 13, 1000
VERLYN D. THOKAS
508

Date 2/9/86 Bysx This survey Consists of

. : page(s) Marrative JACKSON COUNTY SURVEYOR

38-IW-26C T.L. 204 (Part)

SURVEY NARRATIVE TO COMPLY WITH O.R.S. 209.250

FOR:

Moreland Smith

6381 Wagner Creek Road Talent, Oregon 97540

LOCATION:

East 1/2 Sec. 26, T. 38 S., R. 1 W., W. M., City of

Talent, Jackson County, Oregon.

DATE:

January, 1988

PURPOSE:

To monument parcel according to legal description

furnished by client.

PROCEDURE:

The subject parcel is one of several created within a larger parcel surveyed and monumented by Survey No. 3835. Original corner monuments were recovered and the subject parcel surveyed as shown on the accompanying plat. Monumented side line from Survey

No. 3835 used for bearing control.

SURVEYOR:

Verlyn Thomas 304 South Holly Medford, Oregon

> * * RECEIVED * * Date 2/9/88 By54 This survey Consists of: _____ sheet(s) Map _____ page(s) Narrative JACKSON COUNTY SURVEYOR

REGISTERED **PROFESSIONAL** LAND SURVEYOR

OREGON
MAY 13, 1960
VERLYN D. THOMAS
505