

**** RECEIVED ****
 Date 2/12/88 By SK
 This survey consists of:
 - sheet(s) Map
 - page(s) Narrative
JACKSON COUNTY
SURVEYOR

REGISTERED PROFESSIONAL LAND SURVEYOR <i>Darrel W. Edwards</i> OREGON JULY 8, 1966 DARREL W. EDWARDS 741	SURVEY FOR: GEORGE NEARY	
	SCALE: 1" = 200' DATE: DEC. 1987	MONUMENTS FOUND AS NOTED O SET 5/8"x24" STEEL PIN W/PLASTIC CAP: PLS 741 () DEED RECORD
	LOCATION: SE 1/4 SEC. 12, T. 36 S., R. 3 W.W.M., SW 1/4 SEC. 7 & NW 1/4 SEC. 18, T. 36 S., R. 2 W.W.M., JACKSON COUNTY, OREGON.	
	SURVEY BY: DARREL W. EDWARDS 2000 BROOKHURST No. 27 MEDFORD, OREGON 97504	R.S.N.: RECORDED SURVEY NUMBER Ph. 776-2313

SURVEY NO 11108

SURVEY NARRATIVE TO COMPLY WITH PARAGRAPH 209.250,
OREGON REVISED STATUTES.

SURVEY FOR: George Neary
c/o Landline Realty
2568 St. Charles Way
Medford, Or. 97504

LOCATION: Southeast 1/4 of Section 12, Township 36 South, Range
3 West of the Willamette Meridian.
Southwest 1/4 of Section 7 and Northwest 1/4 of
Section 18, Township 36 South, Range 2 West of the
Willamette Meridian, Jackson County, Oregon.

PURPOSE: Survey Lot Line Adjustment approved by the Jackson
County Department of Planning and Development.

PROCEDURE: Used monuments set in Recorded Survey No. 11086 and
right of way pins set by the Jackson County Department
of Public Works for control. Set survey markers to
establish new property lines as approved by the Jackson
County Department of Planning and Development. Set
5/8" by 2 1/4" steel pins with yellow plastic caps stamped
"DW EDWARDS- PLS 741" Survey of tract to be described
and 30 foot easement as shown on the accompanying plat.

BASIS OF BEARINGS: Gold Key Subdivision.


DATE COMPLETED: January 15, 1988.

SURVEY BY: Darrel W. Edwards
2000 Brookhurst #27
Medford, Or. 97504
phone 776-2313

REGISTERED
PROFESSIONAL
LAND SURVEYOR

Darrel W. Edwards

OREGON
JULY 8, 1966
DARREL W. EDWARDS
741

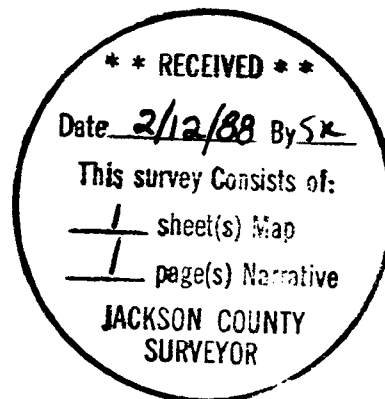

36-3W, 12, T.L. 502
36-2W, 7, T.L. 100
36-2W, 18, T.L. 100 & 103