

Survey no. 1115

Survey Narrative to comply with O.R.S. 209-205 and O.R.S. 209-120

Survey for: D. Vincent


Survey by: Edward A. McGinty 3/23/58

BASIS OF BEARING: Previous survey of records.

PRECEDENCE OF SURVEY:

Surveyed tract as shown from deeds of record which was based on a prior survey, County Survey No. 486.

Found a 5/8 in. iron pin being the point of beginning, as shown on the map, and center line monument according to City Engineers data. Set the northwest corner deed record distance and measured deed record angle. Set easterly pins on line of pins found along easterly line of previous survey and record angle shown from westerly line. Found small discrepancy in remeasurement of the south and somewhat larger to the north. Surveyed tract as shown to believe the original intent of conveyance.

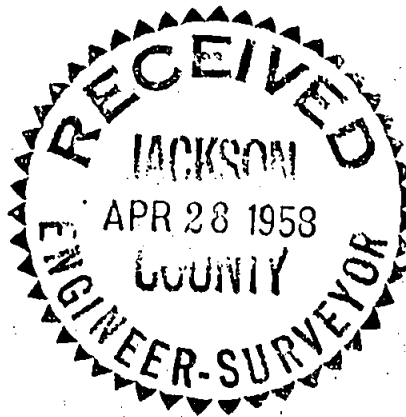

Edward A. McGinty
JULY 10, 1953
EDWARD A. MCGINTY
301