

MAP of SURVEY

Located in the Southwest quarter of section 19, Township 39 South, Range 2 West, of the Willamette Meridian, Jackson County, Oregon.

For


STUART V. HINSON

Basis of Bearing: Filed survey No. 5843

- Found 5/8" iron pin as described
- Set 5/8" x 24" iron pin with yellow plastic cap marked "FARBER LS 2189"

Scale: 1" = 50'

Date: June 10, 1988

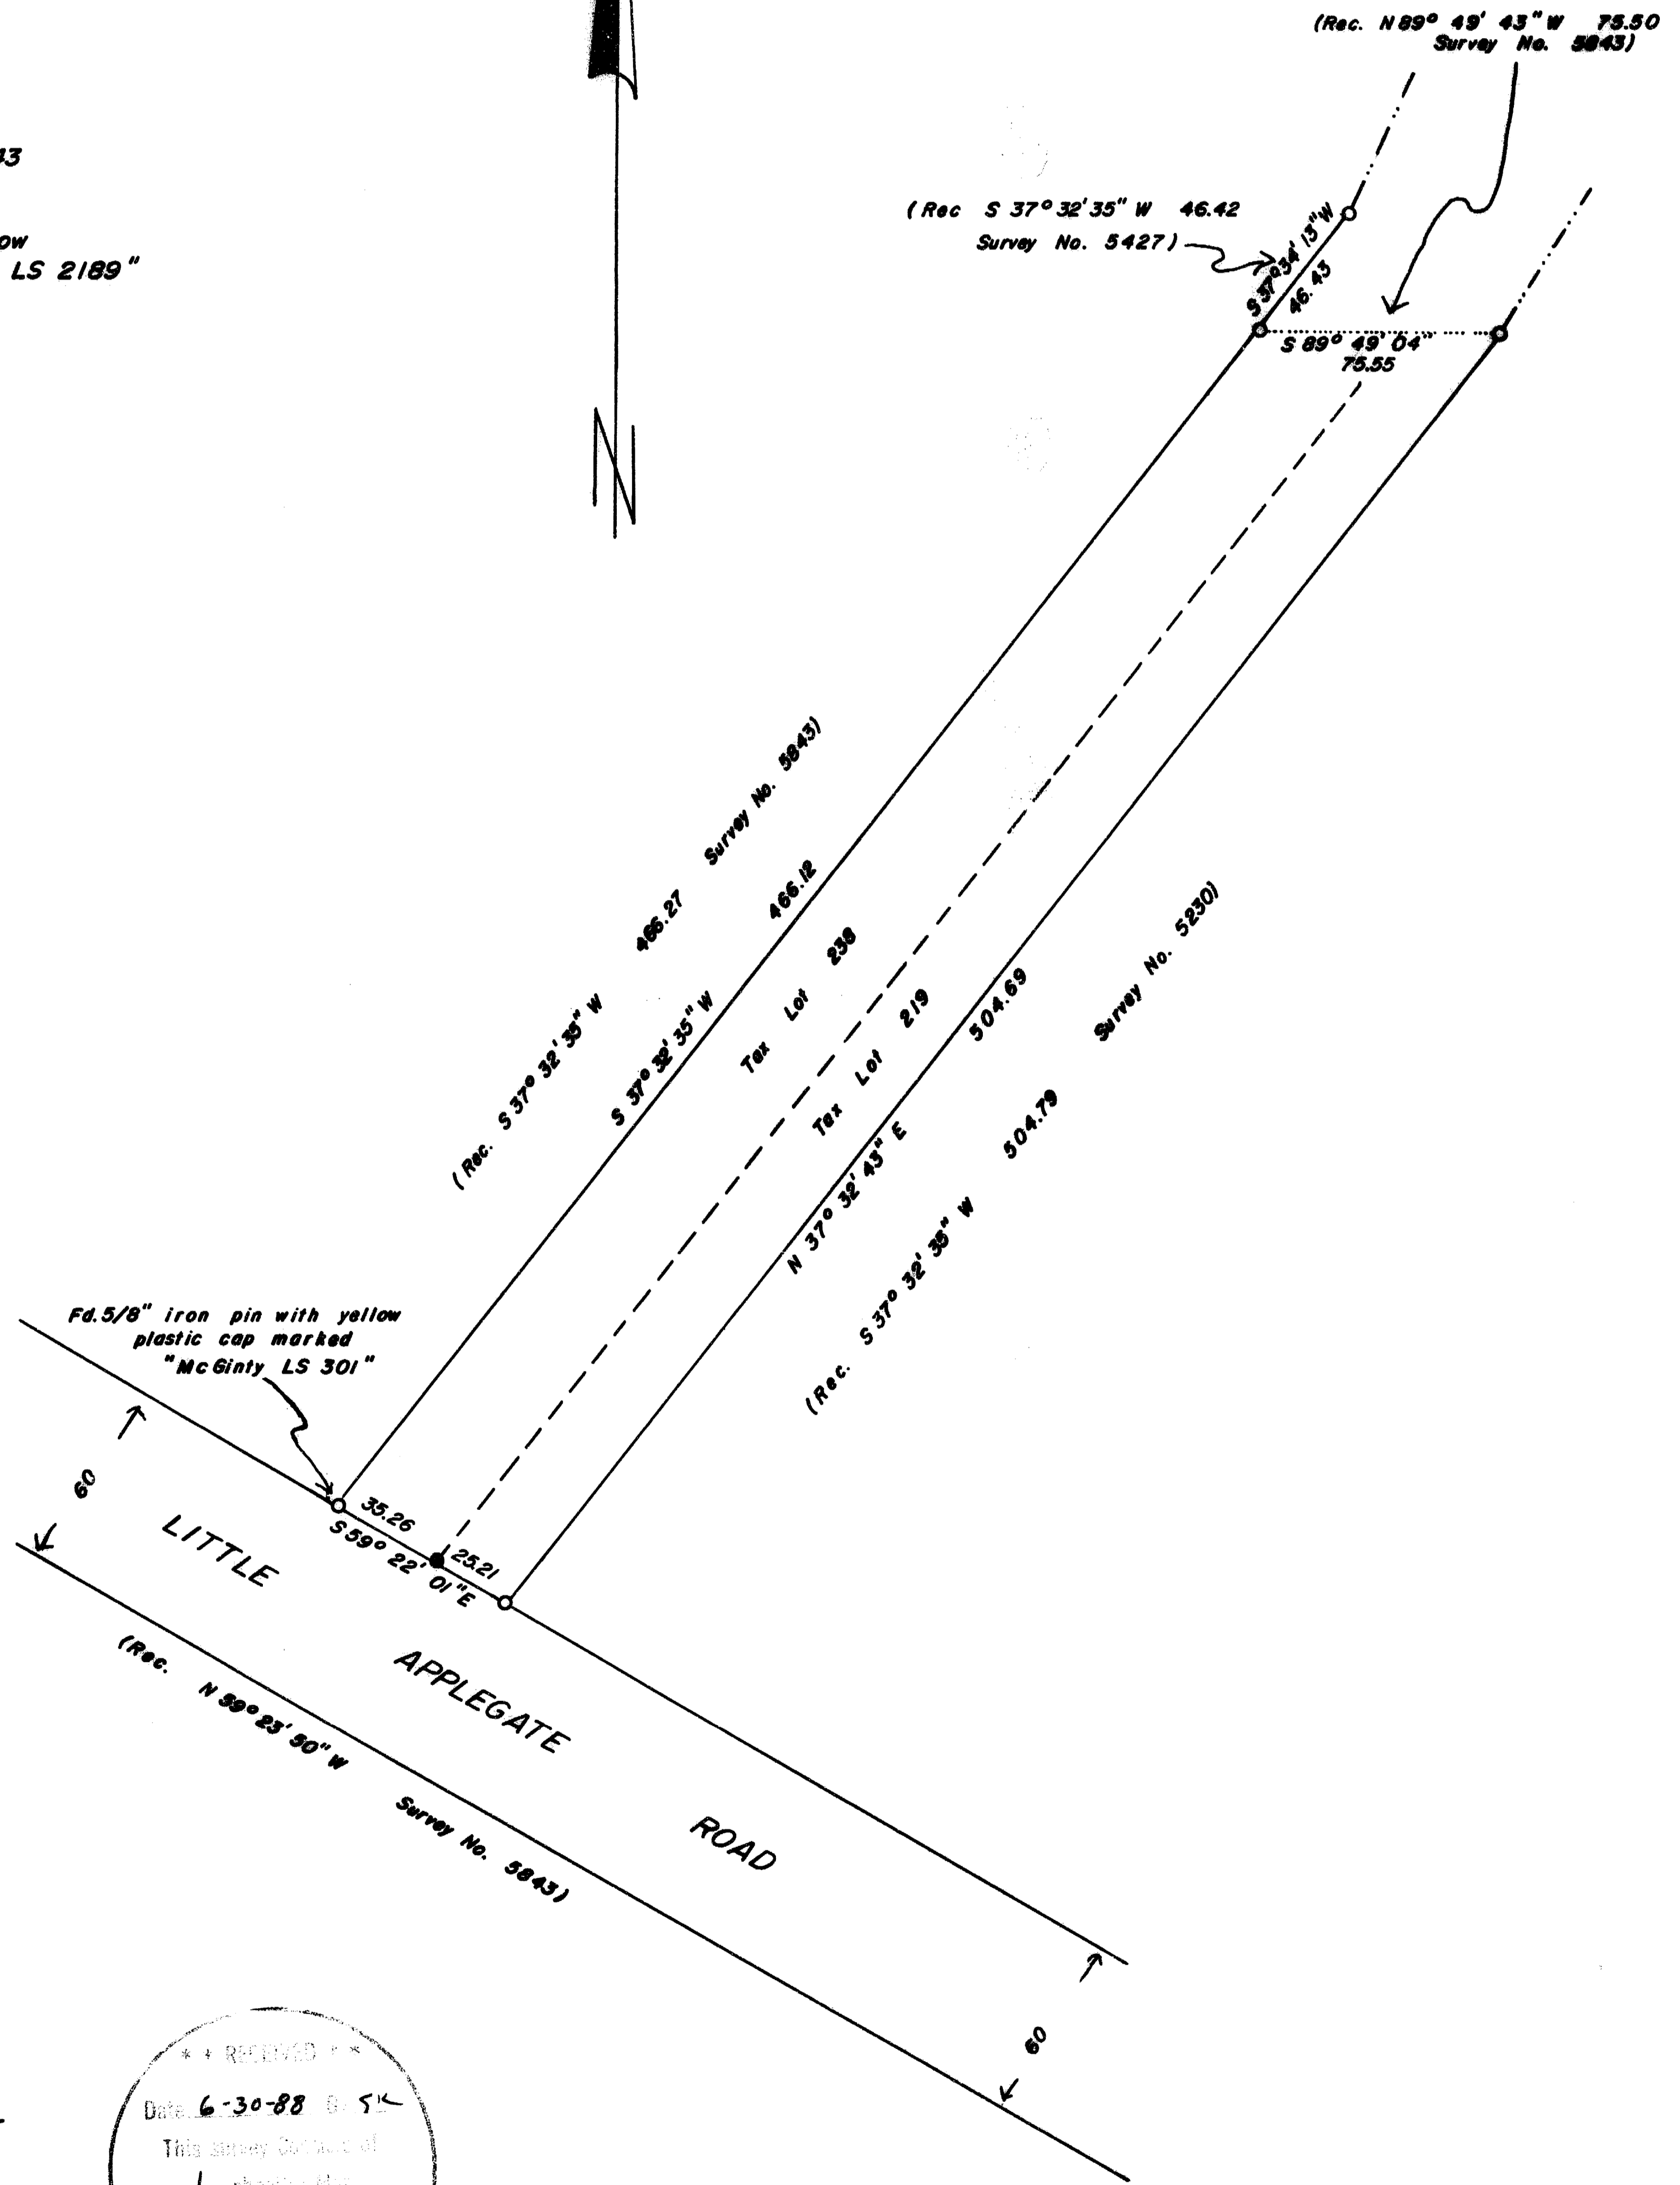

Surveyed by: Farber Surveying
P.O. Box 1311
Jacksonville, Oregon
97530

REGISTERED
PROFESSIONAL
LAND SURVEYOR

Herbert A. Farber

OREGON
1917 No. 1945
HERBERT A. FARBER
2019

RECEIVED
Date: 6-30-88 8:54
This survey consists of
1 sheet(s) Map
1 page(s) Narrative
JACKSON COUNTY
SURVEYOR

Survey No. 11213

SURVEY NARRATIVE TO COMPLY WITH O.R.S. 209.250.

Survey for: Stuart V. Hinson
4020 Little Applegate Road
Jacksonville, Oregon 97530


Location: Located in the southwest quarter of Section 19,
Township 39 South, Range 2 West of the Willamette
Meridian, Jackson County, Oregon.

Purpose: To monument the property corner as shown on the
accompanying map.

Procedure: I tied the monuments as shown and set the property
corner as per Instrument No. 86-9165 of the Official
Records of Jackson County, Oregon.
Bearing is based on filed survey no. 5843.

Surveyed by: Farber Surveying
P.O. Box 1311
Jacksonville, Oregon 97530

Date: June 10, 1988

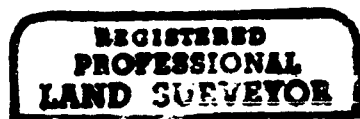

Herbert A. Farber

