

Paul Rynning
County Surveyor
Medford, Oregon

SUBJECT: Re-establishment of obliterated corner.



Township 34 South, Range 2 West, W.M.

Corner of sections 11, 12, 13 and 14, found remains of one bearing tree to the southwest, now being a 24 inch leaning black oak snag. T bisible on low blaze and scribe on high blaze on over growth visible T 34 S and R 2 W. From where the tree was, before leaning, set a 4 inch fir post in a small rock mound, N.16°E., 13 lks. from which

Blazed a fir, 10 ins. diam., N.22°W., 59½ lks. (not scribed)
Blazed a laurel, 12 ins. diam., N.18°E., 45 ¾ lks. (not scribed)
Blazed a laurel 8 ins. diam., S.52°E., 14½ lks. (not scribed)
Blazed a laurel 10 ins. diam., S.53°W., 20 lks. (not scribed)
Original B T now a 24 in. snag from original position bears S.16°W., 13 lks.

Assistants:

D. Daley
W. H. Aftring, Timber Products, Inc.
D. W. Pruitt, Timber Products, Inc.

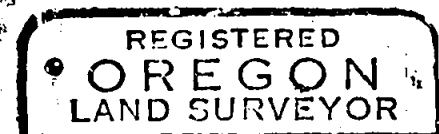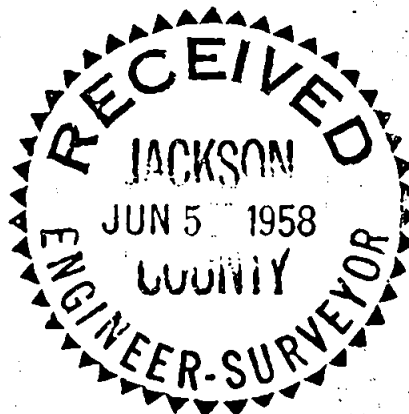

Edward A. McGinty

