

11245

SURVEY IN GOV'T. LOT 1,  
SEC. 27, T. 37 S., R. 1 W., W.M.  
JACKSON COUNTY, OREGON.

FOR

Scott Lewis  
1700 Laurel Court  
Coos Bay, OR 97420

SURVEY PLAT & NARRATIVE TO COMPLY WITH PARAGRAPH 209.250  
OREGON REVISED STATUTES

Purpose : To monument the W line of O.R. 80-05286.

Procedure: Utilization of existing monuments per  
Survey No. 6024 as shown hereon.

SE cor. Lot 4, Block 6,  
BEL AIR HTS. EXT. NO. 2




REGISTERED  
PROFESSIONAL  
LAND SURVEYOR

*Charles H. Hurst*

OREGON  
OCTOBER 30, 1959  
CHARLES H. HURST  
483

April 28, 1988

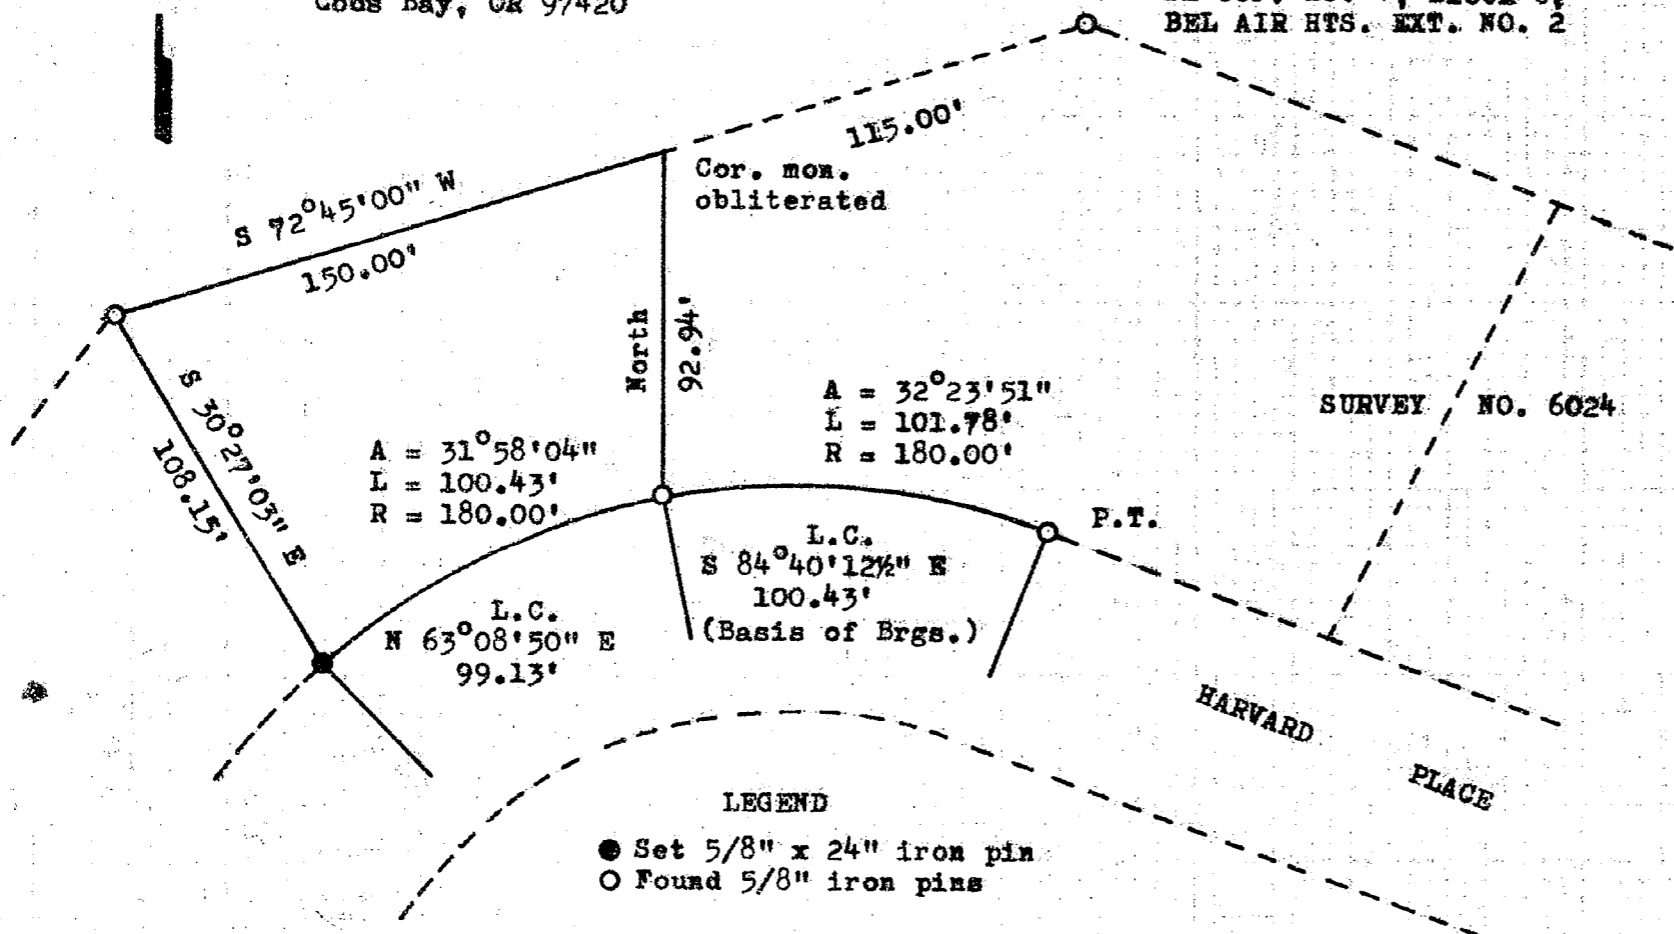

LEGEND  
● Set 5/8" x 24" iron pin  
○ Found 5/8" iron pins

\*\* RECEIVED \*\*  
Date 7/26/88 By SLC  
This survey consists of  
1 sheet(s) Map  
0 page(s) Narrative  
JACKSON COUNTY  
SURVEYOR

Tax Lot 1000 11245