


SURVEY
 SMALLWOOD PARK
 Section 29, T.34 S. R. 1 W.
 Jackson County, Oregon.
 Scale 1" = 200' Hugh C. Ingle
 May, 1958. Civil Engineer.

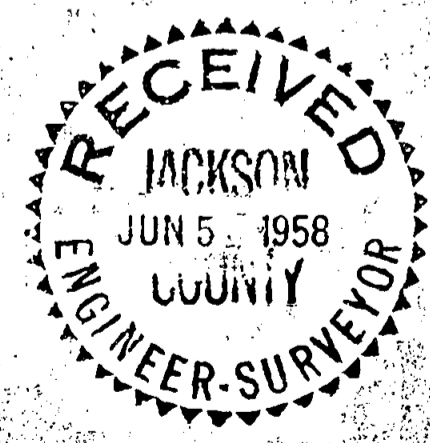

NARRATIVE REPORTSurvey forMrs. Eleanor Smallwood

in

Section 29, T. 34 S. R. 1 W. N. E.Jackson CountyOregonPurpose of Survey.

To establish boundaries and sub-dividing lines for property and deed exchange on adjacent parcels.

Procedure

Found Section Corner 20, 21, 28 and 29 and checked to survey points of C. Z. Boyden Survey #136 which agreed.

Traversed west line of County road for one boundary by 30 foot measure from center line of travelled way and the west boundary on line requested by owner. Set 3/4" pipes at all corners.

Bearings correspond to those of Boyden survey.

