

**MAP OF SURVEY
LOCATED IN**

**BLK. 2, STAGE COACH HILLS SUBDIVISION, UNIT NO. 1
SECTION 32AC, T.37S., R2W., W.M.
JACKSON COUNTY, OREGON**

**FOR
JACK BATE
NO. 6 POINT PLACE
WRIGHTSVILLE BEACH, NORTH CAROLINA**

**HOFFBUHR and ASSOCIATES, INC.
219 N. OAKDALE
MEDFORD, OREGON**

**BY: DOUGLAS C. McMAHAN L.S. NO 1913
SCALE: 1"=60' JUNE 28, 1988
BASIS OF BEARING: STAGE COACH HILLS
UNIT NO. 1**

- = Fd. 5/8" iron pin
- = Set 5/8" x 24" iron pin w/yellow plastic cap stamped "D. McMAHAN L.S. 1913"

**REGISTERED
PROFESSIONAL
LAND SURVEYOR**

Douglas C. McMahon

**OREGON
JULY 18, 1980
DOUGLAS C. McMAHAN
No. 1913**

**** RECEIVED ****
Date 8/1/88 By JK
This survey consists of
1 sheet(s) Map
1 page(s) Narrative
**JACKSON COUNTY
SURVEYOR**

SURVEY NO. 11251

SURVEY NARRATIVE TO COMPLY WITH PARAGRAPH 209.250
OREGON REVISED STATUTES

SURVEY FOR: Jack Bate
No. 6 Point Place
Wrightsville Beach,
North Carolina 28480


LOCATION: Block 2, Stage Coach Hill Subdivision, Unit
No. 1, Northeast one-quarter (1/4) of Section
32, Township 37 South, Range 2 West,
Willamette Meridian, Jackson County, Oregon

PURPOSE: To survey and monument the North line of Lot 2
as per the client's request and as shown on
the attached map of survey


PROCEDURE: Utilizing found monuments and control
established by this office for Survey No.
11192, I set monuments as shown on the attached
map.

Basis of Bearing: Stage Coach Hills Subdivision, Unit No. 1

June 28, 1988

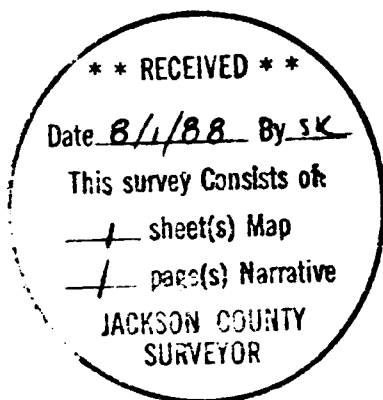

Douglas C. McMahan

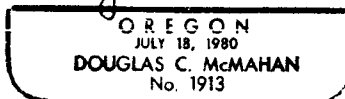

Douglas C. McMahan
Hoffbuhr & Associates, Inc.
219 North Oakdale
Medford, Oregon 97501