

SURVEY FOR:  
MAYNARD INDUSTRIES  
400 OYSTER POINT BLVD. SUITE 123  
SOUTH SAN FRANCISCO  
CALIFORNIA, 94080


SURVEYED BY:  
MARQUESS & ASSOCIATES INC.  
MEDFORD, OREGON

LOCATION:  
NORTHEAST QUARTER, SECTION 29  
T.36 S., R.2 W., W.M.,  
JACKSON COUNTY, OREGON

**\*\* RECEIVED \*\***  
Date 8/23/88 By X  
This survey consists of:  
1 sheet(s) Map  
1 page(s) Narrative  
JACKSON COUNTY  
SURVEYOR

• SET 5/8" X 30" REBAR WITH  
YELLOW PLASTIC CAP MARKED  
"MARQUESS & ASSOC."

REGISTERED  
PROFESSIONAL  
LAND SURVEYOR  
*Robert Joseph Milts*  
OREGON  
SEPTEMBER 23, 1977  
ROBERT JOSEPH MILTS  
No. 1270

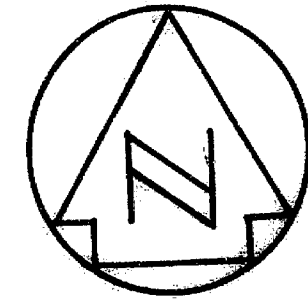

SCALE: 1"=200'

AUG 16, 1988

N.E. COR. D.L.C. 69  
FOUND 2 1/2" DIA.  
BRASS CAP ON 1 1/2"  
DIA. I. PIPE

TAX LOT 1000  
MAP 362W20

SOUTHERN PACIFIC RAILROAD R/W  
S 35°08'00" E

RS 356

TOLO ROAD BASIS OF BEARINGS S 0°12'40" W  
2956.96' (REC. 2956.92)

N 89°47'20" W  
1379.36'

TAX LOT 200  
MAP 362W20

FOUND  
5/8" I. PIN

RS 1862

FOUND  
5/8" I. PIN

FOUND  
5/8" I. PIN

S 89°55'20" E 1180.30  
(REC. S 89°55'30" E 1180.09)

FOUND  
1 1/4" I. PIPE

FOUND  
1" I. PIPE

E.S.E. COR. D.L.C. 69  
FOUND 1 1/2" DIA.  
STEEL ROD WITH  
CENTER PUNCH

MAI JOB NO. 1-3491

SURVEY NO. 11282

SURVEY NARRATIVE TO COMPLY WITH PARAGRAPH 209.250  
OREGON REVISED STATUTES

SURVEY FOR: Maynard Industries  
Suite 123  
400 Oyster Point Blvd.  
South San Francisco, Ca. 94080

LOCATION: Northeast quarter of Section 29, Township 36 South, Range 2 West,  
Willamette Meridian, Jackson County, Oregon.

Tax Lot 200, Map 36 2W 29  
Tax Lot 1000, Map 36 2W 20

PURPOSE: To monument the new dividing line between Tax Lots 200 and 1000.  
This line was located for a lot line adjustment.

EQUIPMENT: Lietz Set 4 Total Station


PROCEDURE: The found monuments shown at the corners of DLC No. 69 were used  
to establish the east line of DLC No. 69. The new lot line was  
set perpendicular to the DLC line at distance of 587.30'  
northerly of the found 1-1/4" iron pipe shown.

The found monuments shown from RS 1862 were used to establish the  
southwesterly R/W line of the railroad.

MARQUESS & ASSOCIATES, INC.  
1120 East Jackson Street  
P. O. Box 490  
Medford, Oregon 97501



*Robert Joseph Milts*  
Robert Joseph Milts  
Professional Land Surveyor

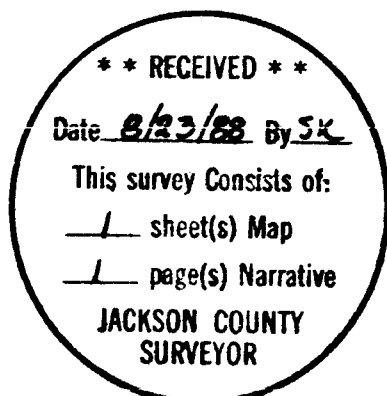

MAI Job No. 1-3491