

SURVEY IN SEC. 20, T. 37 S., R. 2 W., W.M.  
FOR  
ARCH JOHNSON

BY EDWARD MC GINTY  
MEDFORD, OREGON  
JUNE 26, 1958

SCALE 1" = 200'  
Ø = 3/4" I. PIPE

REGISTERED  
OREGON  
LAND SURVEYOR

*Edward A. McGinty*

JULY 10, 1933  
EDWARD A. MCGINTY  
301

RECEIVED  
JACKSON  
JUN 30 1958  
COUNTY  
ENGINEER-SURVEYOR

Survey No. 1130

Survey Narrative to comply with O.R.S. 209-205 and O.R.S. 209-120

Survey for: Arch Johnson



Survey by: Edward A. McGinty  
6/26/58

BASIS OF BEARING: Previous survey.

PRECEDENCE OF SURVEY:

Found the northwest corner of Section 20 and the north quarter corner of Section 20 as shown. Made search for the south quarter corner of Section 20, which has been considered lost for many years, found no evidence of original corner.

Found 3/4 inch pipe next to fence post which has been accepted for many years as the southwest corner Government lot 3, old fence line to the north and east. From this, calculated course to the west 1/16 corner, between section 17/20. The south line of the northwest 1/4 ~~corner~~ of the northwest 1/4 was determined from previous survey of record. Surveyed parcel as shown.

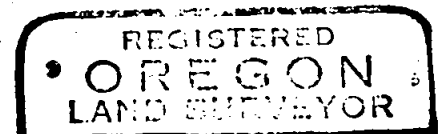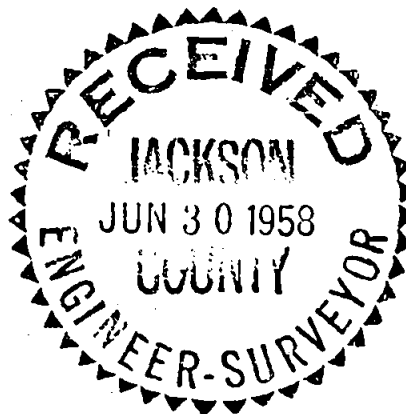

*Edward A. McGinty*

