

FD. STEM OF BRASS DISC 2" DEEP

**\*\* RECEIVED \*\***  
 Date 9-12-88 By RL  
 This survey consists of:  
 / sheet(s) Map  
 / page(s) Narrative  
**JACKSON COUNTY SURVEYOR**

SCALE: 1" = 50'

**MAP OF SURVEY**

LOCATED IN  
 PORTIONS OF LOTS 2, 3, 4 & 5, BLOCK 14,  
 ORIGINAL TOWN OF CENTRAL POINT, -  
 S. E. 1/4 OF THE S. E. 1/4 OF SECTION 3,  
 T. 37 S., R. 2 W., W. M., JACKSON COUNTY,  
 OREGON.

**LEGEND**

- - FD. LEAD PLUG & TAC
- - FD. 5/8" IRON PIN W/ YELLOW CAP
- - SET 5/8" x 24" IRON PIN W/ YELLOW PLASTIC CAP STAMPED "R. BATH L.S. 1069"
- ⊙ - FD. SURVEY MONUMENT AS NOTED
- BASIS OF BEARING - S/N 11,274
- **NOTE:** REFER TO S/N 11,274 FOR SURVEY OF BLOCK 14

FOR  
**JACKSON COUNTY FEDERAL SAVINGS & LOAN**

**HARDEY ENGINEERING**  
 P.O. BOX 876  
 MEDFORD, OREGON 97501  
 (503) 772-6053

REGISTERED  
**PROFESSIONAL LAND SURVEYOR**

*Richard L. Bath*

OREGON  
 JULY 30, 1976  
 RICHARD L. BATH  
 No. 1069

BY: **RICHARD L. BATH**  
 R.P.L.S. 1069  
 AUGUST 12, 1988  
 SCALE: 1" = 50'

FD. LEAD PLUG & TAC PER S/N 10,400

FD. BRASS DISC IN MONUMENT CASE

**11305**

37 2W 300 (9403)

SURVEY NO. 11305

**SURVEY NARRATIVE TO COMPLY WITH O.R.S. 209.250**

**FOR:** Jackson County Federal Savings and Loan  
1217 Crater Lake Avenue  
Medford, Oregon 97504

**LOCATION:** Portions of Lots 2, 3, 4, and 5, Block 14, Original Town of  
Central Point being in the Southeast quarter (1/4) of  
Section 3, Township 37 South, Range 2 West, Willamette  
Meridian, Jackson County, Oregon.



**EQUIPMENT:** Lietz SET 4

**PURPOSE:** To survey and monument the boundaries of the subject  
property per clients request.

**PROCEDURE:** Using Survey No. 10400 and 11274 as a basis for control,  
verified the mathematical protraction of Block 14 as shown  
on Survey No. 11274. Monumented the boundary of the  
subject property as shown and find a 1.1 foot encroachment  
of the eave of the building located on the lot adjacent to  
the South boundary.

**BASIS OF BEARING:** Survey No. 11274

August 12, 1988

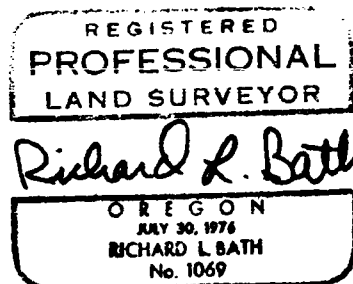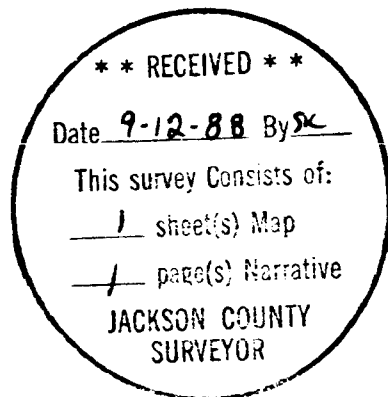

HARDEY ENGINEERING  
Richard L. Bath  
P.O. Box 876  
Medford, Oregon 97501  
(503) 772-6053