

**\*\* RECEIVED \*\***  
 County of JACKSON  
3  
 JACKSON COUNTY

REGISTERED  
**PROFESSIONAL**  
 LAND SURVEYOR  
  
 OREGON  
 JULY 16, 1971  
 LARRY J. FRIAR  
 961

**LEGEND:**

- ⊙ FOUND COUNTY SURVEYOR'S MONUMENT UNLESS NOTED OTHERWISE
- SET 5/8" IRON PIN WITH PLASTIC CAP MKD. FRIAR PLS 961
- ① SEE CORRESPONDING NO. IN NARRATIVE FOR CORNER DESCRIPTION.
- [20.0CH] ORIGINAL SURVEY RECORD DIMENSION
- LINE BLAZED PAINTED & TAGGED WITH ALUM. TAGS MKD. BCC J. PL
- BASIS OF BEARING: SURVEY NO. 3563

**MAP OF SURVEY**  
**FOR**  
**BOISE CASCADE CORP.**  
 LOCATED IN SECTION 1, T. 39 S., R. 3 E.,  
 W. M., JACKSON COUNTY, OREGON.  
 SURVEYED BY: FRIAR & ASSOCIATES, SURVEYORS  
 717 W. 10TH. ST.  
 MEDFORD, OR.

11331

8. One quarter corner Section 1, T39S, R3E & Section 6, T39S, R4E, W.M.

Found 2 1/2" diam. County Surveyors Brass Cap on 1" diam. iron pipe in rock mound from which bears:

A fir 25" diam S 27° W 21.3 ft. healed blaze

A cedar 28" diam. S 76° E 45.2 ft. healed blaze

9. Southwest one sixteenth corner Section 1. Set a 5/8" x 30" iron pin with plastic cap marked FRIAR PLS 961 from which bears:

A fir 12" diam. N 05° W 1.9 ft marked SW 1/16 S1 BT

A fir 17" diam. N 37° E 23.0 ft marked SW 1/16 S1 BT

10. Section corner common to Sections 1, 2, 11 & 12. Found 2 1/2" diam. County Surveyors Brass Cap (1967) on 1" diam iron pipe in rock mound from which bears:

A fir 33" diam. N 32° E 8.5 ft.

A fir 46" diam. S 74° E 23.3 ft.

A fir 12" diam. S 50° W 12.5 ft.

A fir 30" diam. S 65° W 38.0 ft.

A fir 20" diam. N 01° W 19.0 ft.

11. West one sixteenth corner common to Sections 1 & 12. Set 5/8" x 30" iron pin with plastic cap marked FRIAR PLS 961 from which bears:

A fir 6" diam. N 14° W 6.7 ft marked W 1/16 S1 BT



A fir 6" diam. S 87° E 15.3 ft. marked W 1/16 S12 BT

12. One quarter corner common to Sections 1 & 12.

Found 2 1/2" diam. County Surveyors Brass Cap (1976) on 1" diam. iron pipe in rock mound which bears:  
(no bearing trees standing)

Date: September 7, 1988

Larry J. Friar  
L.J. Friar & Associates  
717 W. 10th, Suite 1  
Medford, Oregon 97501

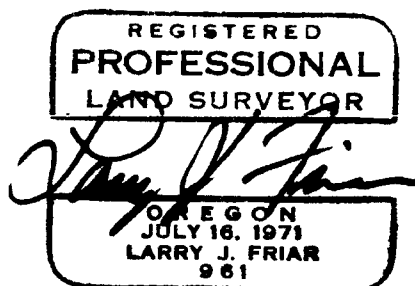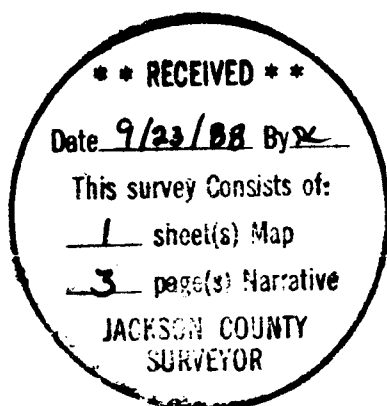

3. Township corner T38S, R3 & 4E, T39S,  
R3 & 4E. W.M.

Found a Standard PLM Brass Capped Pipe  
properly marked 1957 from which bears :  
A fir snag (dead & down) original BT N  
40° E  
A fir 20" diam. N 72° E 43.8 ft.  
healed blaze  
A pine stump original B.T. S 50° E  
36.5 ft. healed blaze  
A fir 18" diam. S 44° E 31.7 ft.  
healed blaze  
A fir 12" diam. S 61° E 5.7 ft. scribe  
visible  
A fir stump 36" diam. S 64° W 22.4 ft.  
original B.T.  
A fir 14" diam. N 73° W 20.0 ft.  
healed blaze

4. North one sixteenth corner common to  
Section 1, T39S, R3E and Section 6,  
T39S, R4E, W.M.

Set 5/8" x 30" iron pin with plastic cap  
marked FRIAR PLS 961 in rock mound from  
which bears:

A fir 6" diam. N 07° W 9.3 ft. marked  
x BT  
A fir 18" diam. S 89° E 72.9 ft.  
marked N 1/16 S6 BT

5. Northwest one sixteenth corner  
Section 1 Set 5/8" x 30" iron pin with  
plastic cap marked FRIAR PLS 961 from  
which bears:

A fir 40" diam. N 55° W 26.5 ft.  
marked NW 1/16 S1 BT  
A fir 6" diam. S 60° W 33.5 ft. marked  
x BT  
Corner of fence running North & East  
bears North 2.0 ft.

6. North one sixteenth corner common to  
Sections 1 & 2

Found 1" galvanized iron pipe from which  
bears:

A fir 18" diam. S 28° E 47.1 ft.  
healed blaze  
A fir 22" diam. S 68° W 56.8 ft.  
healed blaze

7. One quarter corner Sections 1 & 2

Found 2 1/2" diam. County Surveyors  
Brass Cap (1962) on 1" iron pipe in rock  
mound from which bears:

A fir 10" diam. S 88° W 14.4 ft.  
healed blaze  
A fir 11" diam. N 18° W 19.2 ft.  
healed blaze.

Survey No **11331**

Survey Narrative to Comply with ORS 209.250

Survey for: Boise Cascade Corporation  
P. O. Box 100  
Medford, Oregon 97501

Location: Section 1 Township 39 South,  
Range 3 East, Willamette Meridian,  
Jackson County, Oregon

Purpose: To Mark Property Lines and Set  
Fractional Corners

Procedure: A closed control traverse was ran around  
Section 1 tying in controlling section  
corners. The sectional subdivision of  
the N.W. 1/4 and the S.W. 1/4 was then  
computed in proportion to the original  
survey plat.

Property lines indicated on the attached  
map were ran and marked by blazing and  
painting trees and attaching aluminum  
tags, marked BCC/PL.

The following corners were used or  
established by this survey.

1. Section corner common to Section 35  
& 36, T38S, R3E & Sections 1 & 2, T39S,  
R3E, W.M.

Found a 2 1/2 inch diam. iron pipe in  
rock mound exposed 16" from which bears:

A fir 35" diam. N 62° W 15.9 ft.  
scribe visible

A fir 31" diam. N 28° E 17.2 ft.  
scribe visible

A fir 18" diam. N 80° E 37.6 ft. scar

A fir 21" diam. S 68° E 27.8 ft. scar

A fir 27" diam. S 28° W 34.8 ft. scar

2. Quarter corner common to Section 36,  
T38S, R3E & Section 1, T39S, R3E, W.M.

Found a 2 1/2" diam. County Surveyors  
Brass Cap (1976) on a 1" diam. iron pipe  
in rock mound from which bears:

A fir 18" diam. N 58° E 44.1 ft.  
scribe visible

A fir 7" diam. N 25° W 51.4 ft. scribe  
visible

A fir 15" diam. S 70° W 42.0 ft.  
healed scar