

- LEGEND:**
- ⊙ FOUND 2 1/2" DIA. IRON PIPE WITH DIA. BRASS CAP PROPERLY MARKED PLS 961, 1987.
  - ⊙ SET 2 1/2" DIA. IRON PIPE WITH 2 1/2" BRASS CAP MARKED PLS 961, 1988
  - FD. 5/8" IRON PIN WITH 1/4" DIA. ALUM. CAP MKD. LINE MON. PLS 961
  - SET 5/8" IRON PIN WITH PLASTIC CAP MKD. FRIAR P.L.S. 961
  - ⊙ FOUND MONUMENT AS NOTED
- BASIS OF BEARING: SURVEY NO. 11027  
 N.F.S.L. = NATIONAL FOREST SYSTEM LAND.

**MAP OF SURVEY  
 FOR  
 DONNA KING**

LOCATED IN THE S.W. 1/4 OF THE N.E. 1/4 AND  
 THE N.W. 1/4 OF THE S.E. 1/4 OF SECTION 20  
 T. 33 S., R. 1 W., W.M. JACKSON CO., OREGON.  
 SCALE: 1" = 100' DATE: SEPT., 1988  
 SURVEY BY: L.J. FRIAR & ASSOCIATES  
 MEDFORD, OREGON.

SMALL TRACTS ADJUSTMENT  
 AUTHORITY: PUBLIC LAW 97-465, ACT OF JANUARY 12, 1983.  
 96 STAT. 2535, SMALL TRACTS ACT. 36 CFR 254.31  
 SMALL TRACTS ADJUSTMENT CASE NO. 1002

EXAMINED AND ACCEPTED FOR THE  
 U.S. FOREST SERVICE THIS 11<sup>TH</sup>  
 DAY OF October, 1988



*Larry J. Friar*  
 ROGUE RIVER NATIONAL FOREST - LAND SURVEYOR

Survey No. **11348**

Survey Narrative to Comply with ORS 209.250

Survey for: Donna King  
5445 Fish Hatchery Road  
Grants Pass, OR 97527

Location: The S.W. 1/4 of the N.E. 1/4 and the  
N.W. 1/4 of the S.E. 1/4 of Section 20,  
Township 33 South, Range 1 West,  
Willamette Meridian, Jackson County,  
Oregon.


Purpose: To survey, monument and describe a tract  
of land around an existing residence  
which is encroaching on National Forest  
Land in order that the client may obtain  
title through Public Law 97-465 known as  
the Small Tracts Act, Case No. 1002 .

Procedure: The fractional section lines in the N.E.  
1/4 of Section 20 were previously  
determined by this Surveyor during the  
execution of a Cadastral Survey Contract  
with the USDA Forest Service. Filed  
Survey No. 11027.

The North and West lines of the small  
tract were layed out at 100 feet from  
the existing buildings and monumented,  
the Right-of-Way of the Highway was  
established at 66.00 feet from a  
surveyed line along the existing  
centerline stripe.

Also set monuments on the South line of  
the clients property as shown on the  
attached map. No direct tie was made to  
the South East Section Corner. The  
position was determined from a Bureau of  
Land Management Retracement Survey and  
ties made to the corner by the Jackson  
County Surveyors office during the re-  
establishment of the South one quarter  
corner of Section 20.

Date: September 8, 1988

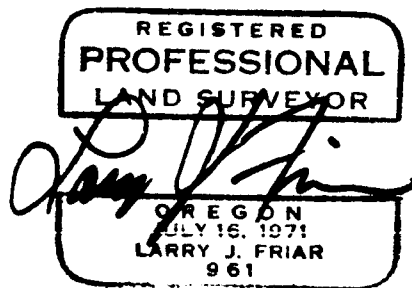

Larry J. Friar  
L.J. Friar & Associates  
717 W. 10th, Suite 1  
Medford, Oregon 97501

