

38-2W-6 T.L. 1900, 1901, 1902, 1903, 1904 & 1905

SURVEY FOR: Tom Terbeck		
SCALE: 1" = 100'	SURVEY BY: Edwards Surveying	DRAWN BY:
DATE: Sept. 20, 1988	Phone: 664-1539 1014 East Pine St. Central Point, Oregon 97502	REVISED:
LOCATION: In the Southeast 1/4 of Section 6, T. 38 S., R. 2 W., W.M. in Jackson County, Oregon.		
● Monument found as noted	() Record data as noted	DRAWING NUMBER:
○ 5/8" x 24" steel pin w/cap set	x-x-x Fence Line	

RECEIVED
Date: 10/19/88
This survey was prepared by
Edwards Surveying
Central Point, Oregon

David W. Edwards

SURVEY NUMBER 11352

SURVEY NARRATIVE TO COMPLY WITH CHAPTER 209, PARAGRAPH 250, OREGON REVISED STATS.

SURVEY FOR: Tom Terbeck
1455 Riverside
Medford, Oregon

LOCATION: In the Southeast $1/4$ of Section 6, Township 38 South, Range 2
West of the Willamette Meridian, Jackson County, Oregon.

PURPOSE: To locate and monument the boundaries of six existing tax lots
and the physical center of an unimproved roadbed.

PROCEDURE: Tied to controlling monuments as shown on the attached plat.
Utilizing recorded survey number 8735 for a tie to the South $1/4$
corner, computed the subdivision of the Southeast $1/4$ of the
Section. A combination of field ties and Jackson County Department
of Public Works record data was used to compute the location of
Sterling Creek Road. Set $5/8$ " x 24" steel pins with yellow plastic
caps marked "DW EDWARDS PLS 741" as shown on the attached plat.

BASIS OF
BEARINGS: Recorded Survey Number 8735


EQUIPMENT: Lietz TM-20C theodolite and Lietz Red-1 E.D.M.

DATE COMPLETED: September 20, 1988

SURVEY BY: Edwards Surveying
1014 East Pine Street
Central Point, OR. 97502
Phone: 664-1539

REGISTERED
PROFESSIONAL
LAND SURVEYOR

Darrel W. Edwards
OREGON
JULY 8, 1966
DARREL W. EDWARDS
741

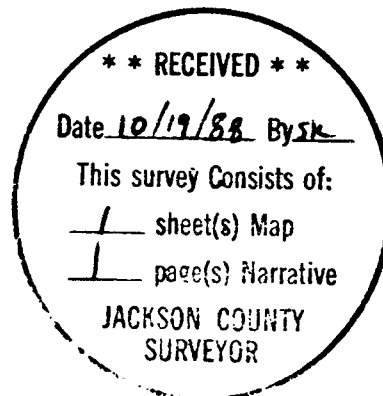

38-2N-6 T.L. 1900, 1901, 1902, 1903, 1904, 1905

Edwards Surveying and Land Planning Inc.
 Registered Land Surveyors
 1014 East Pine St.
 Central Point, Oregon 97502
 (503)664-1539

SURVEY NARRATIVE TO COMPLY WITH CHAP. 209, PAR. 250, OREGON REVISED STATUTES

SURVEY FOR: Omega Ministries Inc.
 11250 S. Fork Little Butte Creek Rd.
 Eagle Point, Oregon 97524

LOCATION: Southwest Quarter and Southeast Quarter of Section 8,
 Township 37 South, Range 3 East of the Willamette Meridian
 in Jackson County, Oregon.

PURPOSE: Set witness corner to South Quarter corner of Section 8
 and flag South line of Section 8 from the West 1/16
 corner to South Fork of Little Butte Creek.

PROCEDURE: Traversed between found monuments shown on accompanying
 plat. Set witness corner and pin on West bank of South
 Fork of Little Butte Creek. Set 5/8" x 24" steel pins
 with yellow plastic cap stamped "D.W. EDWARDS - PLS 741".

EQUIPMENT: Lietz TM-20C Theodolite and Lietz Red-1 E.D.M.

**BASIS OF
 BEARINGS:** Recorded Survey No. 9113

DATE COMPLETED: October 14, 1988

** RECEIVED **
 Date 10/17/88 By SK
 This survey Consists of:
1 sheet(s) Map
1 page(s) Narrative
 JACKSON COUNTY
 SURVEYOR

REGISTERED
 PROFESSIONAL
 LAND SURVEYOR

Darrel W Edwards

OREGON
 JULY 8, 1966
 DARREL W. EDWARDS
 741