

11372




SCALE 1"=500'

Basis of Bearings: Solar Observ.

LEGEND

- = Set 5/8" x 24" I. Pin (tagged R.L.S. 638)
- ⊙ = Fd. C.S. 1" br. capped pipe and B.T.s
- //// = Lines blazed and pointed red
- G.R. = Gov. record bearing and distance

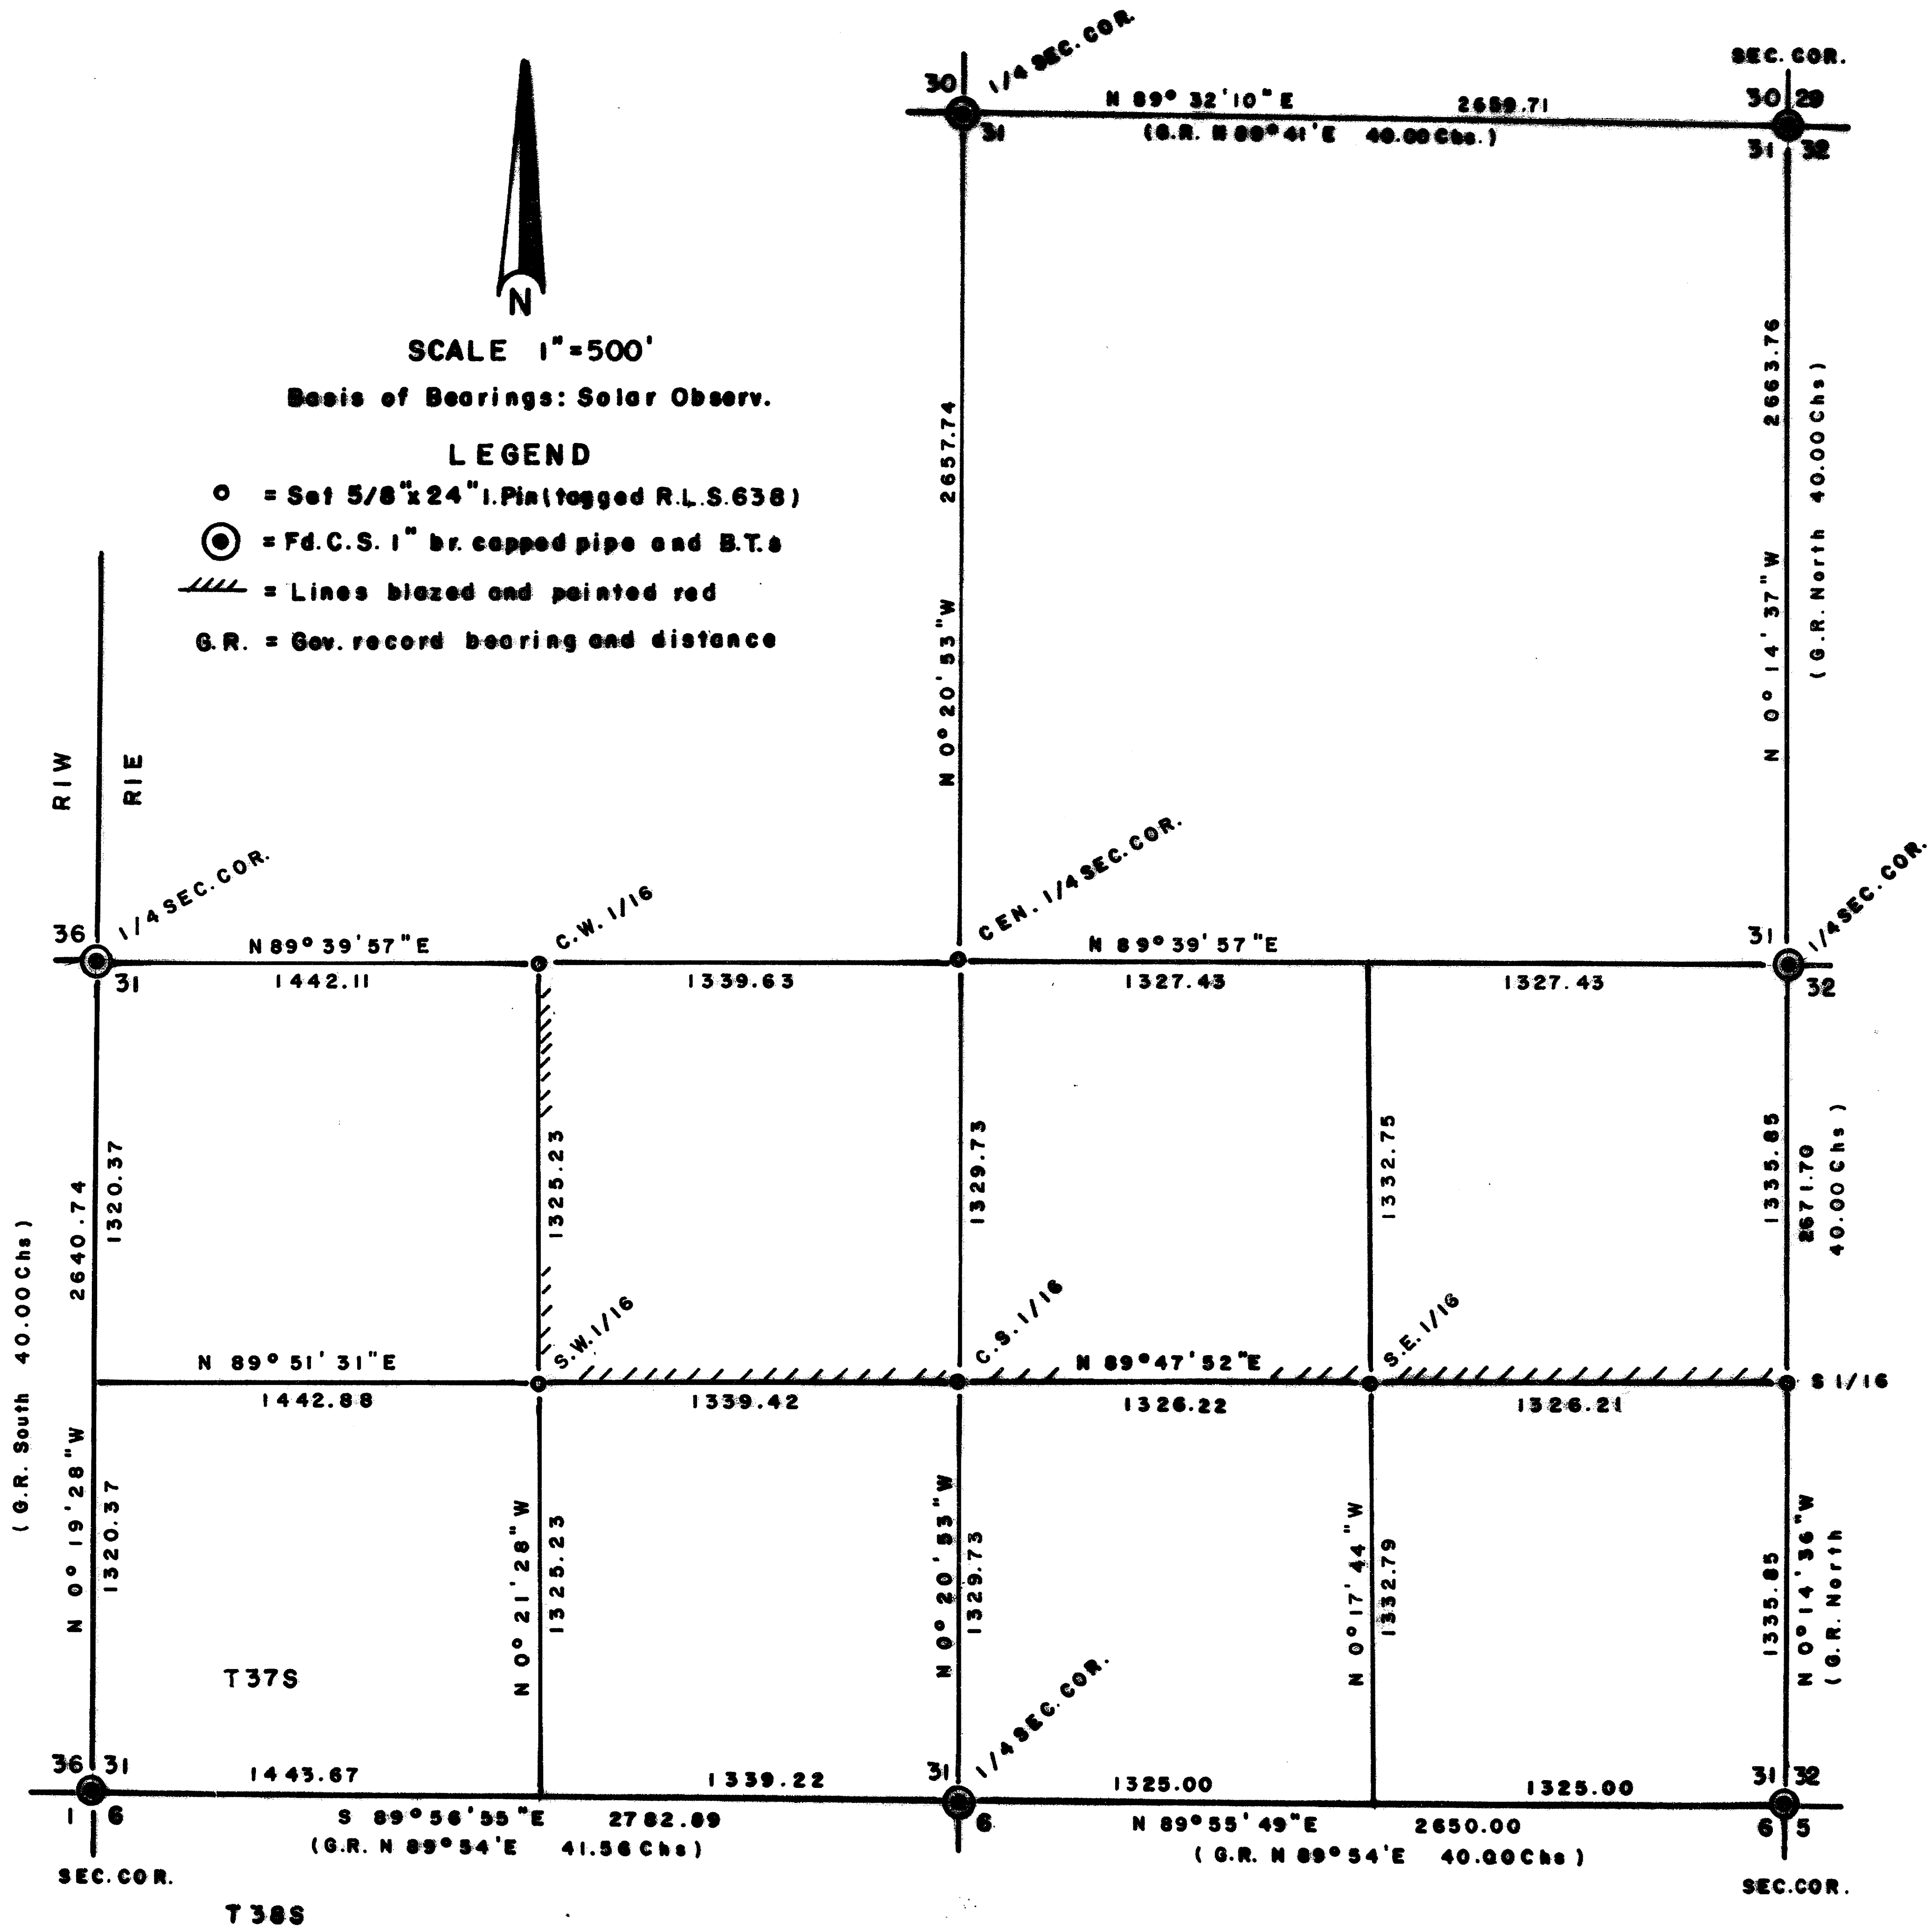

**\*\* RECEIVED \*\***  
 Date 11-3-88 By [Signature]  
 This survey Consists of:  
 1 sheet(s) Map  
 1 page(s) Narrative  
 JACKSON COUNTY  
 SURVEYOR

REGISTERED  
**PROFESSIONAL  
 LAND SURVEYOR**  
*George Burrell*  
 OREGON  
 JULY 19, 1964  
 GEORGE R. BURRELL  
 438

**MAP OF SURVEY**  
 Located in Section 31, Twp. 37S, R1E  
 For: ROBERT FERNS  
 By: George Burrell, R.P.L.S 10/24/88

11372

SURVEY NARRATIVE TO COMPLY WITH O.R.S. 209.250

FOR: Robert Ferns  
4732 Fern Valley Road  
Phoenix, Oregon

PURPOSE:

To subdivide, monument the corners and mark the lines between 1/16 section corners of section 31 as shown on the accompanying map.

PROCEDURE:

The Meridian was determined by Solar Observation near the East 1/4 section corner. A random traverse was run between all exterior section corners of control utilizing E.D.M. and Theodolite. From coordinate data thus developed, the sectional subdivision was computed and the corners and lines monumented as shown on the accompanying map.

Bearing Tree's were marked for the interior section corners as established by this survey as follows:

At the Center 1/4 Sec. corner; a 6" Fir marked C 1/4 BT bears S 0° 25' E 31.0 feet to the center at blaze height; a 10" Fir marked C 1/4 BT bears S 64° 12' E 9.0 feet to the center at blaze height; at the CW 1/16 corner; a 6" Fir marked CW 1/16 BT bears S 3° 24' W 12.8 feet to the center at blaze height; a 9" Fir marked CW 1/16 BT bears S 74° 03' E 5.8 feet to the center at blaze height; at the SW 1/16 corner; a 8" Fir marked SW 1/16 BT bears S 46° 42' E 21.6 feet to the center at blaze height; at the CS 1/16 corner; a 13" Fir marked CS 1/16 BT bears S 36° 33' E 23.1 feet to the center at blaze height; a 17" Fir marked CS 1/16 Bt bears S 32° 24' W 23.5 feet to the center at blaze height; at the SE 1/16 corner; a 28" Fir marked SE 1/16 BT bears S 55° 00' W 4.4 feet to the face of blaze.

BY:


George Burrell, R.P.L.S.  
1379 Brookdale Road  
Medford, Oregon 97504

Oct. 24, 1988

REGISTERED  
PROFESSIONAL  
LAND SURVEYOR

*George Burrell*

OREGON  
JULY 10, 1964  
GEORGE R. BURRELL  
638

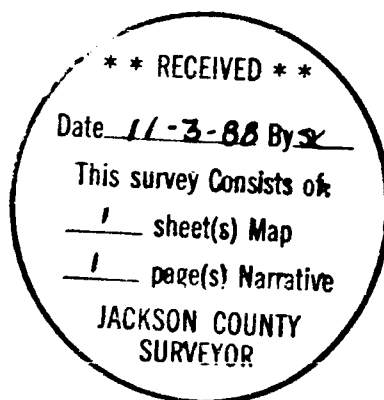

Tax Lot No. 100-37-1E-31