

BASIS OF BEARINGS: R.S.N. 9197

RECEIVED  
 Date: 11/23/88  
 The Surveyor  
 Darrel W. Edwards

REGISTERED  
 PROFESSIONAL  
 LAND SURVEYOR  
 Darrel W. Edwards  
 OREGON  
 DARREL W. EDWARDS  
 741

SURVEY FOR: Rogue River Realty		
SCALE: 1" = 100'	Survey Monuments Found	DRAWN BY: D.W.E.
DATE: Aug. 10, 1988	Set 5/8 x 24" Steel Pin W/Plastic Cap	REVISED
LOCATION: NW 1/4 of Section 12, T. 35 S., R. 4 W. W. M., Jackson County, Oregon.		
SURVEY BY: Darrel W. Edwards 1014 East Pine St. Central Point, Or 97502	DRAWING NUMBER 664-1539	

18X24 PRINTED ON NO. 1000H CLEARPRINT

## SURVEY NARRATIVE TO COMPLY WITH CHAP. 209, PAR. 250, OREGON REVISED STATUTES

SURVEY FOR: Rogue River Realty  
P.O. Box 604  
Rogue River, Oregon 97537

LOCATION: NW 1/4 of Section 12, T. 35 S., R. 4 W., of the W.M., Jackson County, Oregon.

PURPOSE: Survey line to establish a proposed boundary line agreement.


PROCEDURE: Found pins found or set in recorded survey number 9197. Set new pins to establish proposed boundary line agreement. Set 5/8" x 24" steel pins with yellow plastic caps stamped "D.W. EDWARDS - PLS 741".

BASIS OF BEARINGS: Recorded Survey No. 9197

EQUIPMENT: Lietz TM 20C Theodolite, Lietz Red-1 Electronic Distance Meter and 200' steel tape.

DATE COMPLETED: August 10, 1988

SURVEY BY: Darrel W. Edwards  
1014 East Pine Street  
Central Point, Oregon 97502  
(503)664-1539

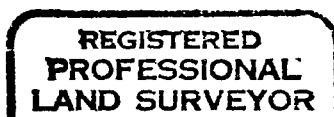

*Darrel W. Edwards*

