


NOTE: Set iron pins on PL. 16 feet West of Road & and of true Property Cor.



SURVEY
Ariel B. Pomeroy Property
PORTION S 1/2 NE 1/4 of S.E. 1/4 Sec. 8
T. 37 S. R. 2 W.
Jackson County, Oregon
Copy July 25, 1958 Hugh C. Ingle
Scale 1" = 200' Civil Engineer

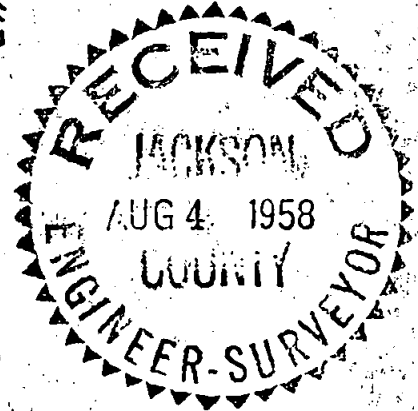

NARRATIVE REPORT

Survey For

Ariel S. Pomeroy

in

S. 1/2 of N. E. 1/4 Sec. 8T. 37 S. R. 2 N.Jackson County, Oregon.Purpose of Survey

To establish lines of property in accordance with description and dividing lines as requested.

Procedure.

Measurement was made from 3/4" pipe marking $\frac{1}{4}$ Corner common to Sections 8 and 9, South along Section line to steel mesh fence along the North line of the Green property. East end of the fence was found to be 8.1 feet South of Deed record distance.

Ran West parallel to fence bearing North of True West. Found stone monument at old Military Road in correct position for description. Ran West from the monument and placed pipe corner at record distance. Found a 3/4" pin 0.3 West of record distance.

Continued survey on record courses and distances and ran intermediate lines.

