

- ⊙ INDICATES BRASS CAP MONUMENT FOUND AS SHOWN
- INDICATES 5/8" x 30" REBAR W/ YELLOW PLASTIC CAP MKD. "TEMPLIN LS 2359" SET.
- BASIS OF BEARINGS BASED UPON SOLAR OBSERVATION
- BLAZED LINE PAINTED RED W/ BLUE FLAGGING

Fd. Jackson County Brass Cap & BT's per Jackson County Reestablishment Book, Pg. 18

Fd. Jackson County Brass Cap & BT's per Jackson County Reestablishment Book, Pg. 33

Fd. Jackson County Brass Cap & BT's per Jackson County Reestablishment Book, Pg. 19

Fd. Jackson County Brass Cap & BT's per Jackson County Reestablishment Book, Pg. 18.

★ RECEIVED ★  
 Date 12-1-88 P. 5  
 This survey consists of  
1 sheet(s) and  
1 page(s)  
 JACKSON COUNTY SURVEYOR

	<b>PLAT of SURVEY</b>
	LOCATED IN N 1/2 of Section 2, T. 37 S., R. 2 E., W.M., Jackson County, Ore. Survey For: Boise Cascade Corp. Medford, Oregon Survey By: Richard Templin Land Surveying 2042 Sandra Pl. Medford, Ore. Date: Nov. 30, 1988 SCALE: 1" = 500'

**RICHARD G. TEMPLIN**  
PROFESSIONAL LAND SURVEYOR

2042 Sandra Pl.  
Medford, Oregon 97504  
(503) 776-0991

NARRATIVE

SURVEY NO. **11408**

**SURVEY FOR:** Boise Cascade Corporation  
North Pacific Highway  
Medford, Oregon

**LOCATION:** Section 2, Township 37 South, Range 2 East,  
Willamette Meridian, Jackson County, Oregon.

**PURPOSE:** To monument the Center 1/4 Corner and  
run true line between the Center 1/4 Corner  
and the North 1/4 Corner of Section 2, T.37S.,  
2E., W.M.


**DATE:** November 30, 1988

**BASIS OF  
BEARING:** Based upon Solar Observation

**PROCEDURE:** Utilizing a Wild T-2, Wild T-16 and Mac iE  
EDM, tied North-East-South-West Quarter  
Corners in by random traverse. At computed  
position for Center One Quarter Corner set  
5/8"x30" rebar from which I scribed the  
following bearing trees:

A Black Oak, 6 " diameter bears S 23°E,  
16.9 feet, scribed "C1/4RLS2359" "BT".  
A Black Oak, 8 " diameter bears N 54°W  
19.0 feet, scribed "C1/4RLS2359" "BT".

Blazed and painted with red paint, True line  
between the Center 1/4 Corner and the North  
1/4 Corner.

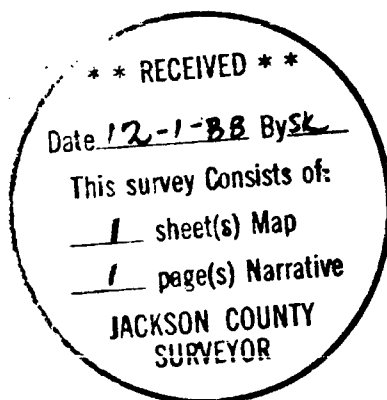

REGISTERED  
PROFESSIONAL  
LAND SURVEYOR

*M G Templin*

OREGON  
JULY 26, 1988  
RICHARD G. TEMPLIN  
2359