
## RECORD OF SURVEY

SOUTHWEST QUARTER of SECTION 2 TOWNSHIP 39 SOUTH, RANGE 1 WEST, WILLAMETTE MERIDIAN JACKSON COUNTY OREGON

DIXIE HELMS

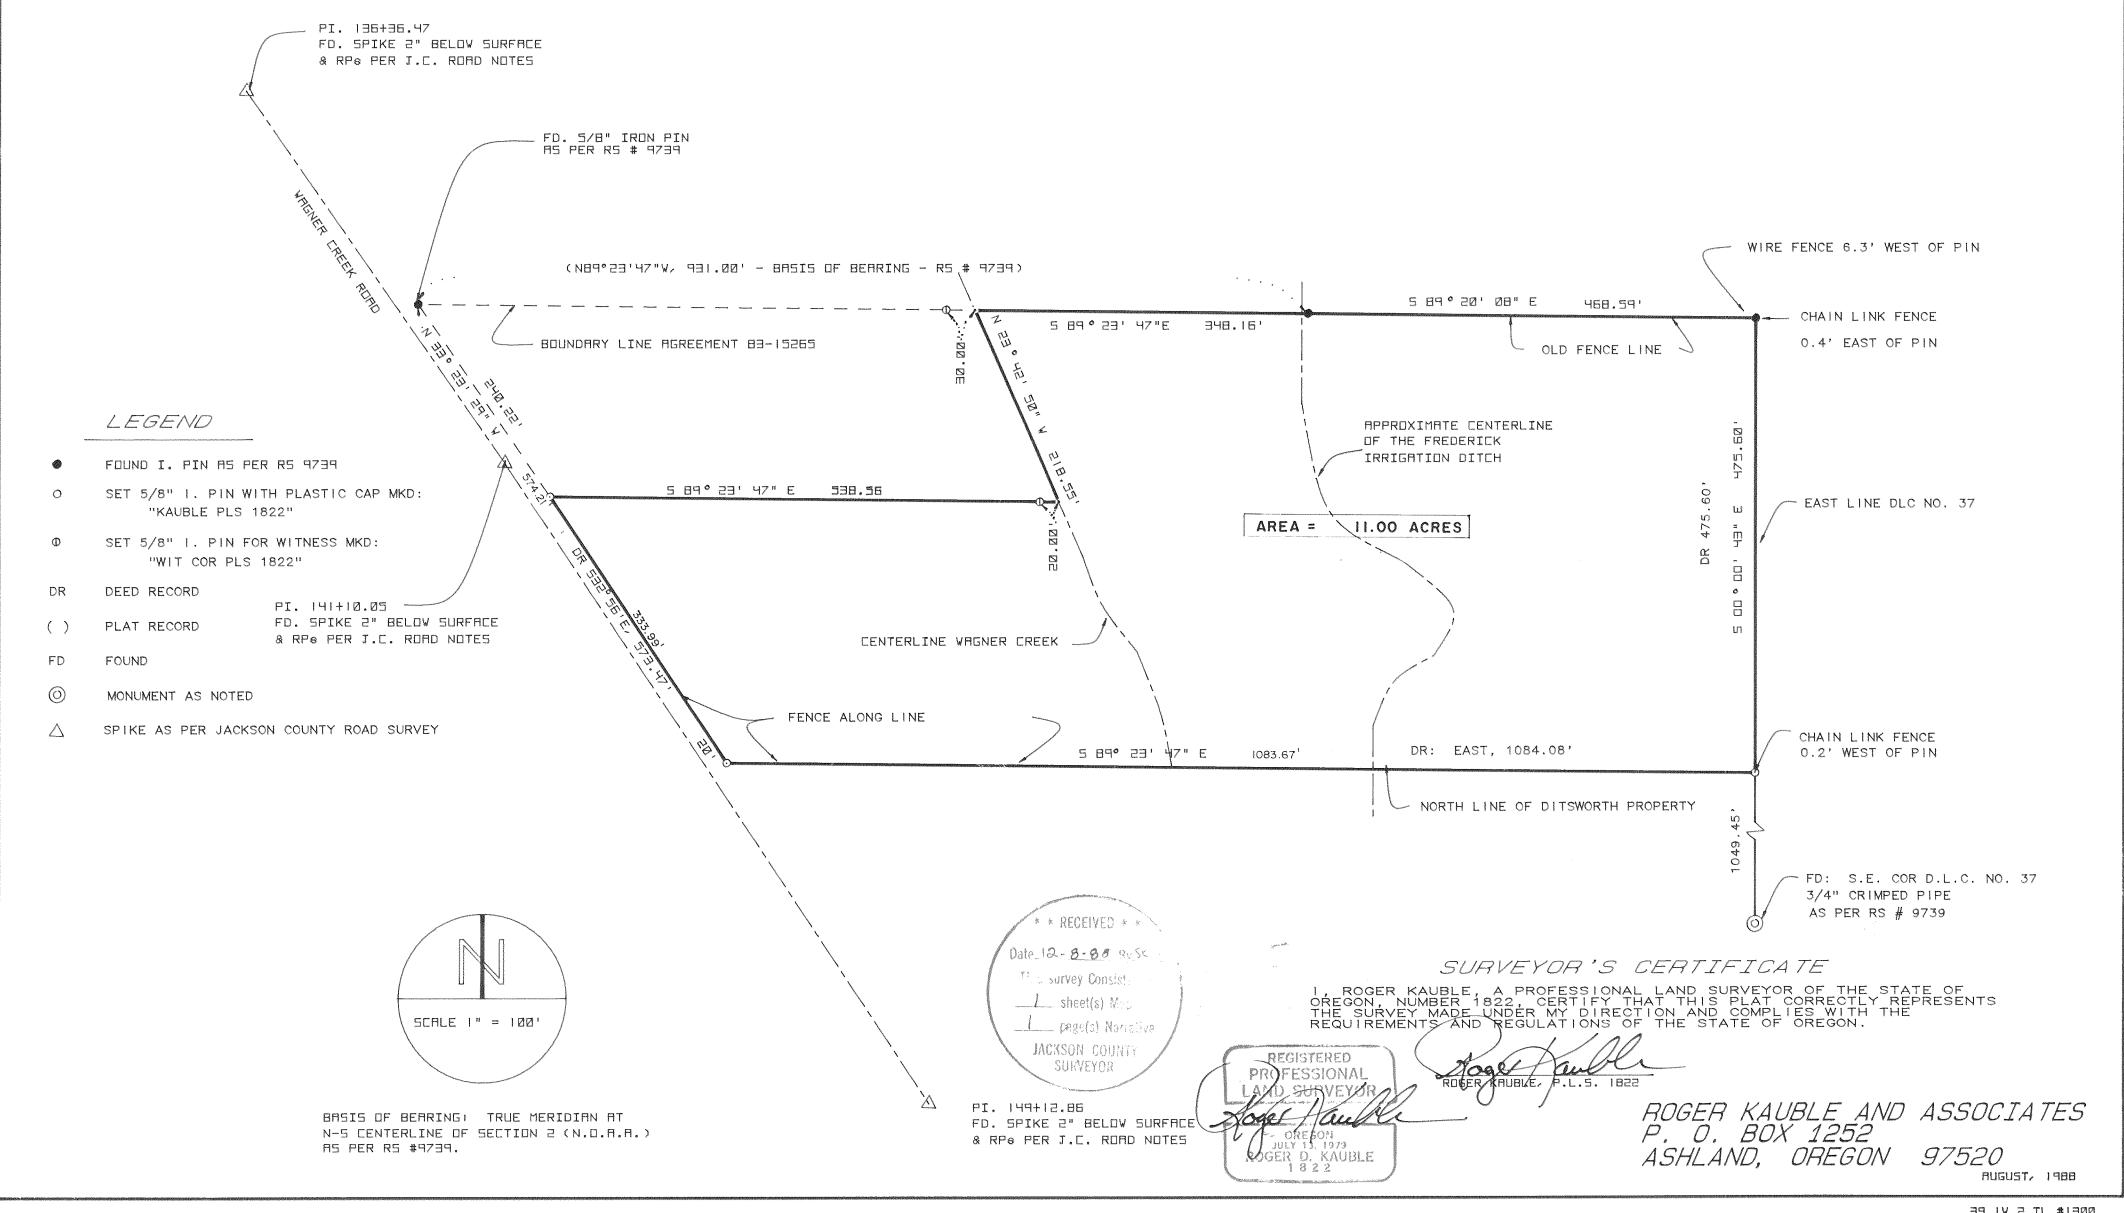

Survey Narrative to comply with Paragraph 209.250 Oregon Revised Statutes

Survey For:

Dixie Helms

9067 Wagner Creek Road Talent, Oregon

Location:

Easterly half of Donation Land Claim 37, situated in the Southwest 1/4 of Section 2, Township 39 South, Range 1 East, Willamette Meridian, Jackson

County, Oregon. "

Purpose:

To monument a tract of land specifically Tax Lot 1300 per Deed Record 80-23355 Jackson County, Oregon as per clients request.

Procedure:

The tract of land along the northerly boundary had been recently surveyed (Record of Survey 10482), so controlling monuments along the northerly boundary were located and tied during the control traverse. Clients deed (80-23355 Deed Record Jackson County, Oregon) makes specific calls to the easterly line of Wagner Creek Road so two spikes set at Points of Intersection (per Jackson County Road Notes), P.I. stations 136+36.47 and 141+10.05 were located and the easterly right of way of Wagner Creek Road A portion of calculated from their position. clients property is also defined by the centerline of Wagner Creek, which was also located and tied during the control traverse. Monuments set along this boundary were witness corners as noted on the accompanying plat.

The monumented boundary fit well with existing improvements, specifically a chain link fence along the entire easterly boundary and a wooden fence along a portion of the southerly boundary approximately 310 feet east of Wagner Creek Road.

Basis of Bearing:

True Meridian at North-South centerline of Section 2 (N.O.A.A.) Record of Survey Number 10482.

The state of the s

Roger Kauble & Associates Post Office Box 1252 Ashland, Oregon 97520 REGISTERED **PROFESSIONAL** August 18, 1988 D-SURVEYOR \* \* RECEIVED \* ROGER D. KAUBLE Date 12 - 8 - 86 By 32 This survey Consists of: / sheet(s) Map page(s) Narrative JACKSON COUNTY SURVEYOR