


8
17
16
1-1/2" Pipe
N 89° 34' 50" W 1321.21'

W. 1/16 Cor. Fd.

N 89° 34' 50" W 1321.21'


1/4 Cor. Fd.

SURVEY IN SEC. 16 T. 38 S., R. 1 W., W.M.
FOR
ALLEN CLARKE

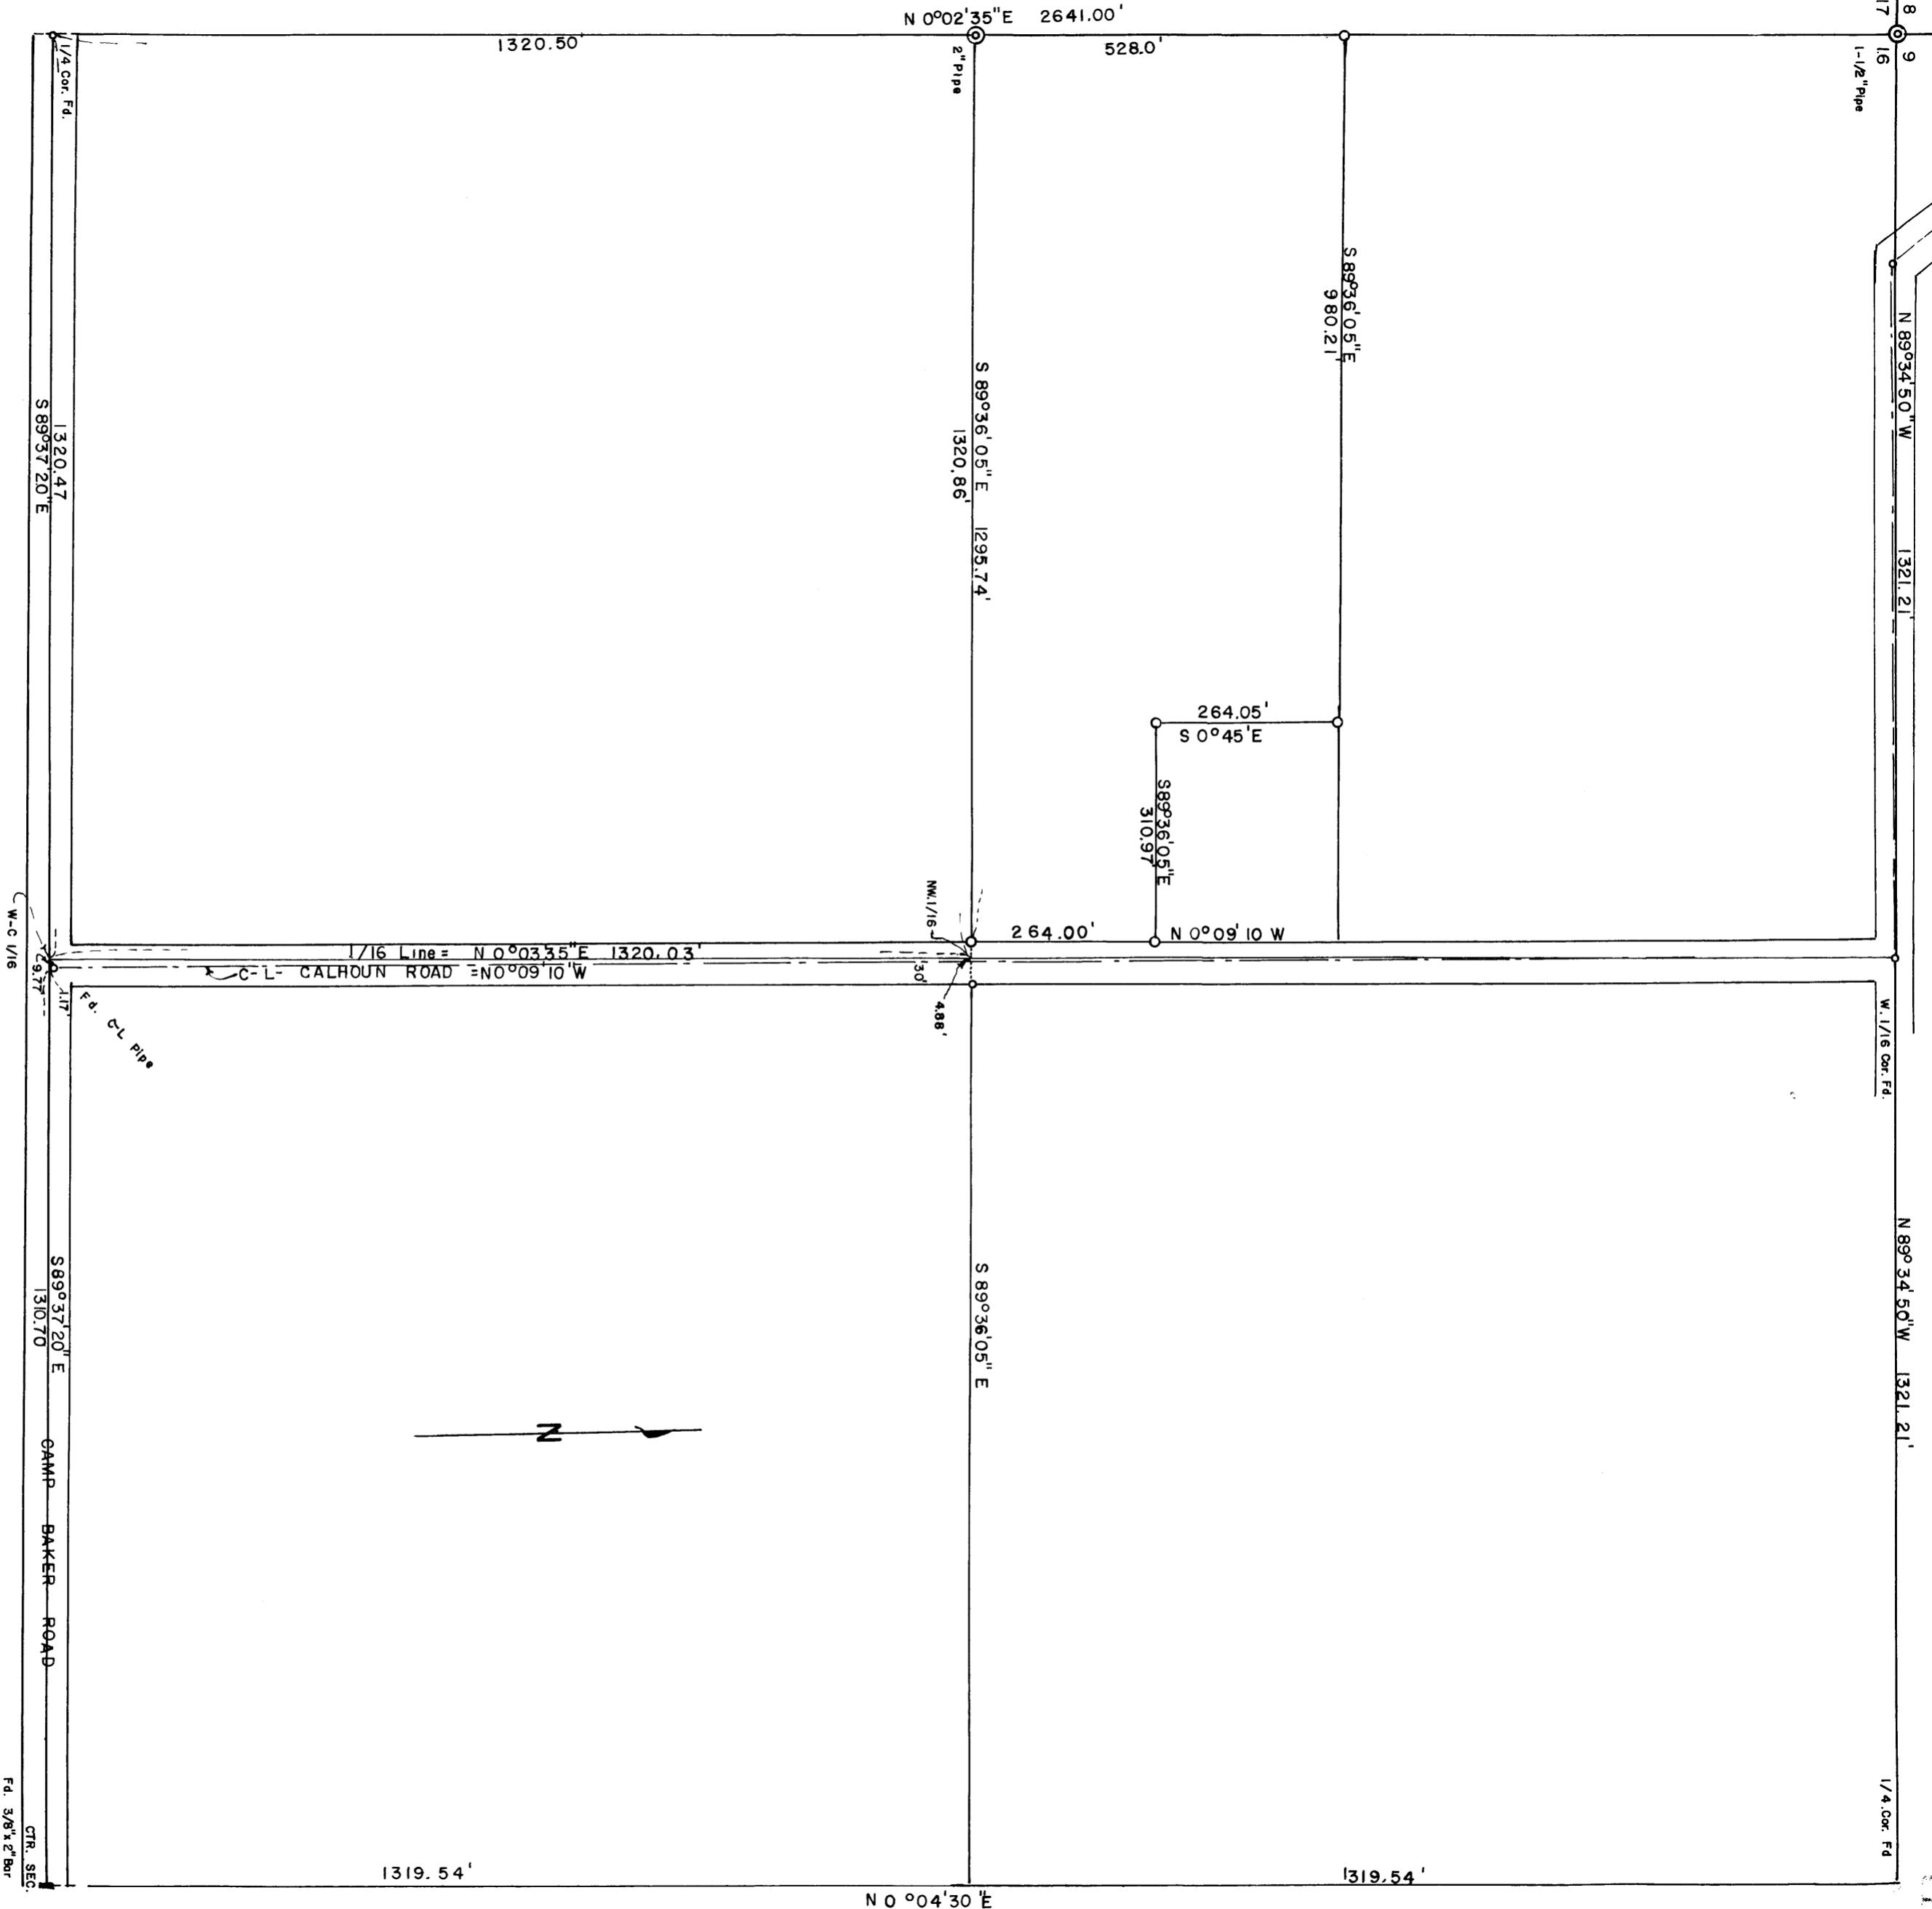

BY E DW. MC GINTY
MEDFORD, OREGON
JULY 1958

SCALE 1" = 200'
○ = 3/4" PIPE
○ = 1/2" PIPE

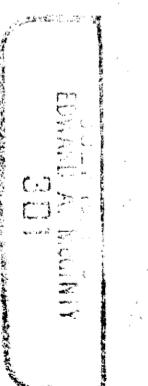

Fd. 3/8" x 2" Bar

CTR. SEC.

Survey No. 1141

Survey narrative to comply with O.R.S. 208-206 and O.R.S 209-120

Survey for: Allen Clarke

Survey by: Edward A. McGinty 8/3/58

BASIS OF BEARING: Previous survey.

PRECEDENCE OF SURVEY:

Sub-divided the northwest quarter of section #6 and surveyed the deeds of record, Vol. 332, page 188 and Vol. 243, page 195.

Found the one quarter corner between sections 17 and 16 and the one quarter corner between section 9 and 16, old excepted corner at the center of section and found the west sixteenth corner between section 9 and 16, from which

1/16 corner and the North 1/4 corner projected line westerly at an equal distance to the northwest corner of section 16.
The center of Calhoun at the northerly end, being the 1/16 cor.
and the southerly end found a 1/2 inch pipe as shown.

