

Paul Rynning
County Surveyor
Medford, Oregon
8-4-58

SUBJECT: Restoration of obliterated corner.

Township 38 South, Range 1 West, Willamette Meridian.

Section corners 8, 9, 16 and 17.



Found the west 1/16 corner between sections 9 and 16, being a 1/2 inch pipe, recognized corner for many years, from the said corner on a straight line projection westerly from the 1/4 corner between section 9 and 16 and the 1/16 corner an equal distance therefrom, dug a hole and found evidence of mound stone (according to local residents, previous monument had been plowed out) at equal and proportional distance set a 1 1/2 inch pipe 28 inches long in the remains of stone mound, 15 inches below surface, from which

A 1/2 inch pipe at the County Rd. P.I., bears S.89°27'50" East, 328.0 ft.
The most northwesterly corner of house bears, S.22°E., 146.3 feet.
The center of a 12 inch locust bears, S.1 1/2°E., 148.8 ft.

From the above section corner, re-established the north 1/16 corner between sections 16 and 17, set a 2 inch pipe, 26 inches long, 12 inches below the surface at a proportional distance, north and south from the 1/4 corner and the section corner, from which

Chiseled cross, on the most southwesterly corner of concrete Irrigation diversion box, bears N.16°W., 11.35 ft.
The center of a three trunk pear tree (the most southwesterly tree in the orchard) bears, N.55°E., 25.9 ft.

Established the ^{from} ~~south~~ ^{north} west 1/16 corner of section 16, by sub-division of the northwest quarter. Corner falls in Calhoun Rd., 4.88 ft. westerly from the center line of said rd., from said corner set reference, a 3/4 inch pipe N.89°36'05"W., 25.12 ft. on the westerly right of way line and a 1/2 inch iron pipe, S.89°36'05"E., 34.88 ft. on the easterly right of way.

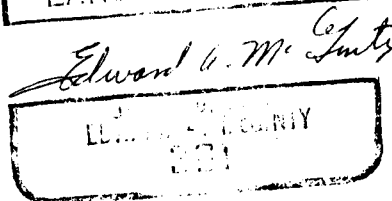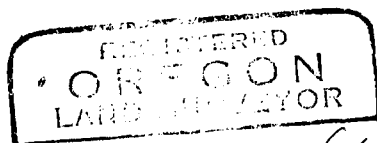

Paul Rynning
County Surveyor
Medford, Oregon
8-4-58

SUBJECT: Restoration of obliterated corner.

Township 38 South, Range 1 West, Willamette Meridian.

Section corners 8, 9, 16 and 17.

Found the west 1/16 corner between sections 9 and 16, being a 1/2 inch pipe, recognized corner for many years, from the said corner on a straight line projection westerly from the 1/4 corner between section 9 and 16 and the 1/16 corner an equal distance therefrom, dug a hole and found evidence of mound stone (according to local residents, previous monument had been plowed out) at equal and proportionl distance set a 1 1/2 inch pipe 28 inches long in the remains of stone mound, 15 inches below surface, from which

A 1/2 inch pipe at the County Rd. P.I., bears S.89°27'50" East, 328.0 ft.
The most northwesterly corner of house bears, S.22°E., 146.3 feet.
The center of a 12 inch locust bears, S.1 1/2°E., 148.8 ft.

From the above section corner, re-established the north 1/16 corner between sections 16 and 17, set a 2 inch pipe, 26 inches long, 12 inches below the surface at a proportional distance, north and south from the 1/4 corner and the section corner, from which

Chiseled cross, on the most southwesterly corner of concrete Irrigation diversion box, bears N.16°W., 11.35 ft.
The center of a three trunk pear tree (the most southwesterly tree in the orchard) bears, N.55°E., 25.9 ft.

Established the ^{North} ~~South~~ west 1/16 corner of section 16, by sub-division of the northwest quarter. Corner falls in Calhoun Rd., 4.88 ft. westerly from the center line of said rd., from said corner set reference, a 3/4 inch pipe N.89°36'05"W., 25.12 ft. on the westerly right of way line and a 1/2 inch iron pipe, S.89°36'05"E., 34.88 ft. on the easterly right of way.

