

PLAT OF SURVEY

LOCATED in Section 7, T.40S., R.4E., W.M.
in Jackson County, Oregon

December 15, 1988

SURVEY FOR: *Boise Cascade Timber & Wood Products Group*
P.O. Box 100
Medford, Oregon 97501

SURVEY BY: *Edwards Surveying & Land Planning Inc.*
1014 East Pine Street
Central Point, Oregon 97502
Phone: 664-1539

Daniel W. Edwards

LEGEND

- o Indicates monument found as noted
- o Indicates 5/8" x 24" steel pin w/plastic cap mkd. "DW EDWARDS-PLS 741" set.
- () Denotes original Gov't survey record data except where noted.
- Indicates blazed and tagged property line
- R.S.N. = Recorded Survey Number
- Fd. = Found
- J.C.S. = Jackson County Surveyor

SCALE: 1" = 400'
BASIS OF BEARINGS: East - West center line Section 7, per R.S.N. 10532.

*** RECEIVED ***
Date 12-21-88 By [Signature]
This survey consists of:
1. A Survey Map
1. A Narrative
1. A County Clerk's Record

Edwards Surveying and Land Planning Inc.
Registered Land Surveyors
1014 East Pine St.
Central Point, Oregon 97502
(503)664-1539

SURVEY NARRATIVE TO COMPLY WITH CHAPTER 209, PARAGRAPH 250,
OREGON REVISED STATUTES

SURVEY FOR: Boise Cascade Timber and Wood Products Group
P.O. Box 100
Medford, Oregon 97501

LOCATION: In Section 7, Township 40 South, Range 4 East
of the Willamette Meridian, Jackson County,
Oregon.

PURPOSE: To locate and monument the boundaries of the
NW 1/4 of the SE 1/4 of said Section 7.

PROCEDURE: Located and utilized for control those
monuments shown on the attached map. Positions
for the North and South 1/4 corners of Section
7 were computed using data shown on Recorded
Survey Number 10532. A closed traverse was
executed around the subject tract and generated
a relative closure of 1:8700. This was then
adjusted and monuments were set as shown.
Monuments set on this survey are 5/8" x 24"
steel pins with yellow plastic caps mkd. "DW
EDWARDS-PLS 741". All bearing trees were
scribed per the B.L.M. Manual and were measured
to the center of the trees at the root crown.

Bearing trees are as follows:

CE 1/16 Corner: 11" Pine bears South 6.43 feet.
11" Pine bears N. 42° E., 11.35 feet.

SE 1/16 Corner: 8" Pine bears S. 25° E., 23.96 feet.
4" W. Oak bears N. 70° W., 44.00 ft.

CS 1/16 Corner: 7" W. Oak bears S. 45° W., 30.70 ft.
bears N. 75° W., 11.06 ft.
An unrecorded 1/2" diam. iron pipe
bears S. 77°18'49" W. 8.06 feet.

Center 1/4 Corner: 7" W. Oak bears S. 58° W. 21.97 feet.
12" Pine bears N. 20° W., 34.95 feet.
An unrecorded 1" diam. iron bar bears
S. 50°28' 32" W., 17.06 feet.


BASIS OF

BEARINGS: East-West center line of Sec. 7 PER R.S.N. 10532


EQUIPMENT: Lietz TM20-C theodolite and Lietz Red-1 E.D.M.

DATE

COMPLETED: December 15, 1988

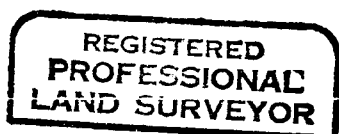

Darrel W. Edwards

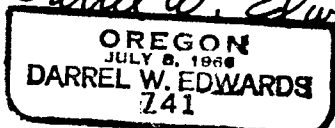

T40-4E-Tax Lot 1803 Date 12-21-88 By SL

