

- ⊙ INDICATES BRASS CAP MONUMENT FOUND AS SHOWN
- INDICATES 5/8"x30" RE-BAR w/ YELLOW PLASTIC CAP MKD. "TEMPLIN LS 2359" SET.
- () RECORD PER ORIGINAL GOVERNMENT PLAT
- INDICATES LINE BLAZED AND PAINTED w/ORANGE PAINT.
- x- INDICATES FENCE
- BASIS OF BEARING BASED UPON SOLAR OBSERVATION.

RECEIVED
 Date: 1/5/89
 This survey conducted by
 1
 Page(s): 1
 JACKSON COUNTY
 SURVEYOR

PROFESSIONAL
 SURVEYOR
 Richard Templin

RICHARD TEMPLIN LAND SURVEYING
 2042 Sandra Pl. Medford, Oregon 97504
 776-0991

PLAT of SURVEY
 LOCATED IN
 SECTION 36, T. 36 S., R. 2 E., W.M., JACKSON COUNTY, OREGON

Survey For: Boise Cascade Corp.
 Medford, Oregon
 Date: Jan. 1, 1989

Scale: 1" = 500'

RICHARD G. TEMPLIN
PROFESSIONAL LAND SURVEYOR

2042 Sandra Pl.
Medford, Oregon 97504
(503) 776-0991

11461

Thence N 89° 36' 08" W, on true line, 1317.44 feet to the South 1/16 corner between Section 35 & 36. At said point set a 5/8"x30" rebar, from which I scribe the following bearing trees:

A Yellow Pine, 24" diameter, bears East, 29.2 feet, scribed "S1/16RLS2359" "BT".

A Cedar, 12" diameter, bears N 2°W, 35.2 feet, scribed "S1/16RLS2359" "BT".

At the Centerwest 1/16 corner set a 5/8"x30" rebar, from which I scribe the following bearing trees:



A White Oak, 6" diameter, bears N 38°E, 9.8 feet, scribed "CW1/16RLS2359" "BT".

A White Oak, 8" diameter, bears S 12°E, 12.9 feet, scribed "CW1/16RLS2359" "BT".


At the Northwest 1/16 corner set a 5/8"x30" rebar, from which I scribe the following bearing trees:

A White Oak, 8" diameter, bears S 78°E, 6.4 feet, scribed "NW1/16RLS2359" "BT".

A White Oak, 8" diameter, bears S 32°W, 10.6 feet, scribed "NW1/16RLS2359" "BT".

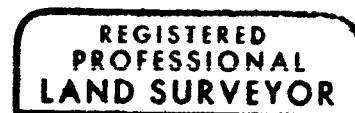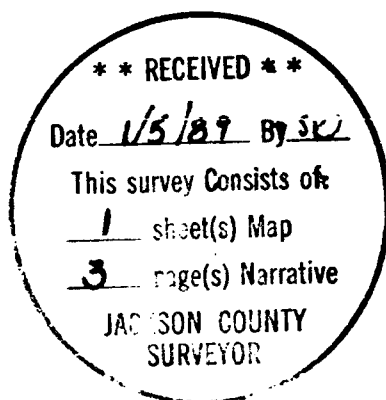

R G Templin

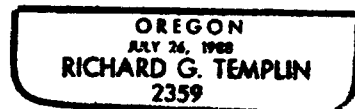

RICHARD G. TEMPLIN
PROFESSIONAL LAND SURVEYOR

11461

2042 Sandra Pl.
Medford, Oregon 97504
(503) 776-0991

Commencing at the Southeast Corner of Section 36 I run on true line N 0° 54' 08" W, 1330.20 feet to the S 1/16 Corner between Section 31 and 36 at said point set a 5/8"x30" rebar from which I scribe the following bearing trees:

A Douglas Fir, 6" diameter bears N 44°E, 30.0 feet, scribed "S1/16RLS2359" "BT".

A Douglas Fir, 12" diameter bears S 44°E, 43.7 feet, scribed "S1/16RLS2359" "BT".

Thence I run on true line N 89° 20' 11" W, 1300.93 feet to the Southeast 1/16 Corner, at said point set a 5/8"x30" rebar from which I scribe the following bearing trees:

A Cedar, 12" diameter bears N 10°E, 20.3 feet, scribed "SE1/16RLS2359" "BT".

A Douglas Fir, 12" diameter bears S 80°E, 24.6 feet, scribed "SE1/16RLS2359" "BT".

Thence I run on true line N 00° 19' 29" W, 1334.51 feet to the Centereast 1/16 Corner, at said point set a 5/8"x30" rebar from which I scribe the following bearing trees:

A White Oak, 9" diameter bears N 39°E, 33.5 feet, scribed "CE1/16RLS2359" "BT".

A White Oak, 6" diameter bears N 74°W, 58.3 feet, scribed "CE1/16RLS2359" "BT".

Commencing at the West 1/16 Corner on the South boundary of Section 36, at said point set a 5/8"x30" rebar, from which I scribe the following bearing trees:

A Yellow Pine, 11" diameter bears N 27°E, 17.0 feet, scribed "W1/16RLS2359" "BT".

A White Fir, 4" diameter bears N 54°W, 68.2 feet, scribed "W1/16RLS2359" "BT".

Thence I run on true line N 00° 31' 25" E, 1349.75 feet to the Southwest 1/16 Corner, at said point set a 5/8"x30" rebar from which I scribe the following bearing trees:

A Cedar, 8" diameter bears S 87°E, 22.9 feet, scribed "SW1/16RLS2359" "BT".

A Cedar, 12" diameter bears S 21°W, 16.3 feet, scribed "SW1/16RLS2359" "BT".

RICHARD G. TEMPLIN
PROFESSIONAL LAND SURVEYOR
2042 Sandra Pl.
Medford, Oregon 97504
(503) 776-0991

NARRATIVE

SURVEY NO. 11461

SURVEY FOR: Boise Cascade Corporation
North Pacific Highway
Medford, Oregon

LOCATION: Section 36, Township 36 South, Range 2 East,
Willamette Meridian, Jackson County, Oregon.

PURPOSE: To monument the Center 1/4 Corner, Northwest
1/16 Corner, North 1/16 Corner between Section
35 and 36, Centerwest 1/16 Corner, Centereast
1/16 Corner, Southeast 1/16 Corner, South 1/16
Corner between Section 31 and 36, South 1/16
Corner between Section 35 and 36, Southwest
1/16 Corner and the West 1/16 Corner on the
South boundary of Section 36.

DATE: January 4, 1989

**BASIS OF
BEARING:** Based upon Solar Observation

PROCEDURE: Utilizing a Leitz Set-4, Wild T16 and Mac 1E
EDM, tied North-East-South-West Quarter
Corners, the Northwest, Southwest and South-
east Section Corners.
At computed position for Center One Quarter
Corner set 5/8"x30" rebar from which I scribed
the following bearing trees:

A Black Oak, 6" diameter bears S 16° E,
14.6 feet, scribed "C1/4RLS2359" "BT".
A White Oak, 6" diameter bears S 68° W,
9.4 feet, scribed "C1/4RLS2359" "BT".

Commencing at the West 1/4 Corner I run
on true line N 0° 10' 12" W, 1303.76 feet to
the North 1/16 Corner between Section 35 and
36. At the Corner set a 5/8"x30" rebar from
which I scribed the following bearing trees:
A White Oak, 10" diameter bears South,
29.8 feet, scribed "N1/16RLS2359" "BT".
A White Oak, 10" diameter bears S 40° W,
32.0 feet, scribed "N1/16RLS2359" "BT".