


11/2/89
1

- INDICATES MONUMENT FOUND AS SHOWN.
- INDICATES 5/8" x 30" RE-BAR w/ YELLOW PLASTIC CAP MKD. "TEMPLIN LS 2359" SET.
- DR DEED RECORD
- () RECORD PER R.S. N° 11352

BASIS OF BEARING BASED UPON THE EAST LINE OF THE SW 1/4 OF SE 1/4 OF SECTION 6 PER R.S. N° 11352.

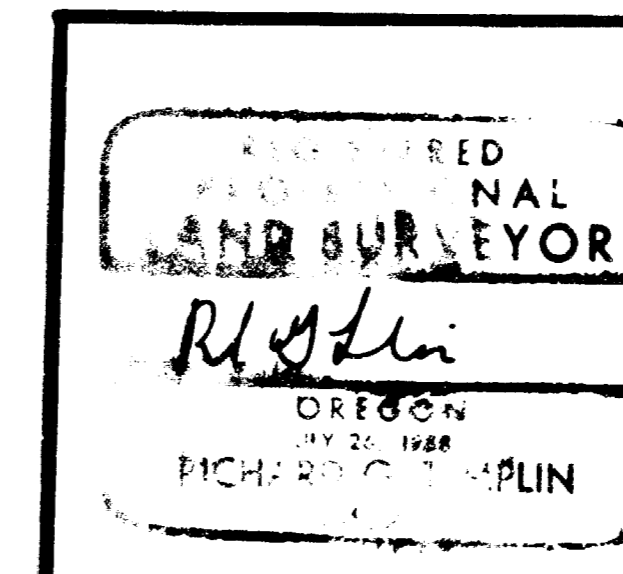


RICHARD TEMPLIN LAND SURVEYING
 2042 Sandra Pl. Medford, Oregon 97504
 776-0991

DEPENDENT RESURVEY
 LOCATED IN
 SW 1/4 of SE 1/4 of Section 6, T. 38 S., R. 2 W., W.M., Jackson County, Or.

Survey For: Mr. Tom De Ascentis & Mr. Gary Miles
 Jacksonville, Oregon
 Date: Dec. 20, 1988 Scale: 1" = 100'

RICHARD G. TEMPLIN
PROFESSIONAL LAND SURVEYOR

2042 Sandra Pl.
Medford, Oregon 97504
(503) 776-0991

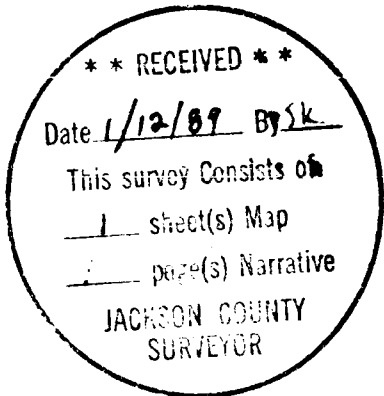

NARRATIVE

SURVEY NO. 11465

SURVEY FOR: Mr. Tom De Ascentis & Mr. Gary C. Miles
298 Sterling Creek Road Jacksonville, Ore.
Jacksonville, Oregon

Location: Located in the S.W 1/4 of the S.E. 1/4 of
Section 6, Township 38 South, Range 2 West,
Willamette Meridian, Jackson County, Oregon.

Purpose: To monument the SW and SE corners of Tax Lot
2000 and to set witness corners to the NW and
NE corners of said Tax Lot. Also set on this
survey was the SW & NW corners of Tax Lot
2001.

Date: December 20, 1988

**Basis of
Bearing:** Based upon the East line of the SW 1/4 of the
SE 1/4 of Section 6 per R.S. No. 11352.

Procedure: Utilizing a Wild T-16 and Mac 1E EDM,
tied in monuments as shown on plat and
computed positions for monuments to be set
from O.R. 86-17380 and O.R. 87-11227. Set
Deed monuments from previously run traverse.
Flagged line between said monuments with Flo-
Red flagging.

