

MAP OF SURVEY

Located in:

S.W. 1/4 of SEC. 19, T.37S., R.1W., W.M.,
JACKSON COUNTY, OREGON

For:

PATRICK G. HUYCKE

Survey by:

HOFFBUHR & ASSOCIATES, INC.
219 N. OAKDALE, MEDFORD, OREGON
DOUGLAS C. McMAHAN - R.L.S. 1913
SCALE: 1" = 20' JANUARY 16, 1989
BASIS OF BEARING = SURVEY NO. 10945

Legend:

- = Set 5/8" x 24" iron pin w/yellow plastic cap stamped "D. McMAHAN L.S. 1913"
- ⊙ = Set lead plug w/washer stamped "L.S. 1913"
- = Found 5/8" iron pin w/yellow plastic cap stamped "MARQUESS & ASSOC."

REGISTERED
PROFESSIONAL
LAND SURVEYOR

Douglas C. McMahar

OREGON
JULY 18, 1980
DOUGLAS C. McMAHAN
No. 1913

** RECEIVED **

Date: *1/20/89* *PHSK*

This survey consists of

- 1 sheet(s) map
- 1 report(s) narrative

JACKSON COUNTY
SURVEYOR

1180

SURVEY NO. 11480

SURVEY NARRATIVE TO COMPLY WITH PARAGRAPH 209.250
OREGON REVISED STATUTES

SURVEY FOR: Patrick G. Huycke
1322 East McAndrews Road, Suite 201
Medford, Oregon 97504

LOCATION: Southwest one-quarter (1/4) of Section 19,
Township 37 South, Range 1 West, Willamette
Meridian, in Block 1 of Fruitdale Addition to
the City of Medford, Jackson County, Oregon


PURPOSE: To survey and monument the property per
client's request and as shown on the attached
map of survey

PROCEDURE: Utilizing found monumentation per Survey's No.
4259 and No. 10945 for control, I established
monuments as shown on the attached map of
survey.


Basis of Bearing: Survey No. 10945

Date: January 16, 1989

(re: 70-013)

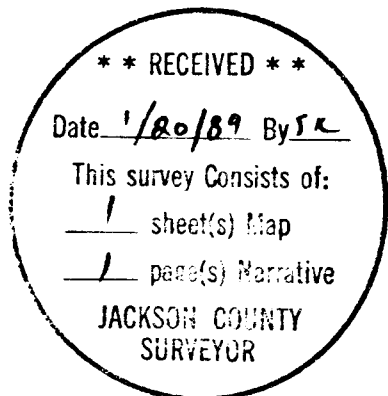

Douglas C. McMahan

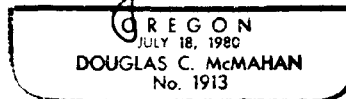

Douglas C. McMahan
Hoffbuhr & Associates, Inc.
219 North Oakdale
Medford, Oregon 97501