

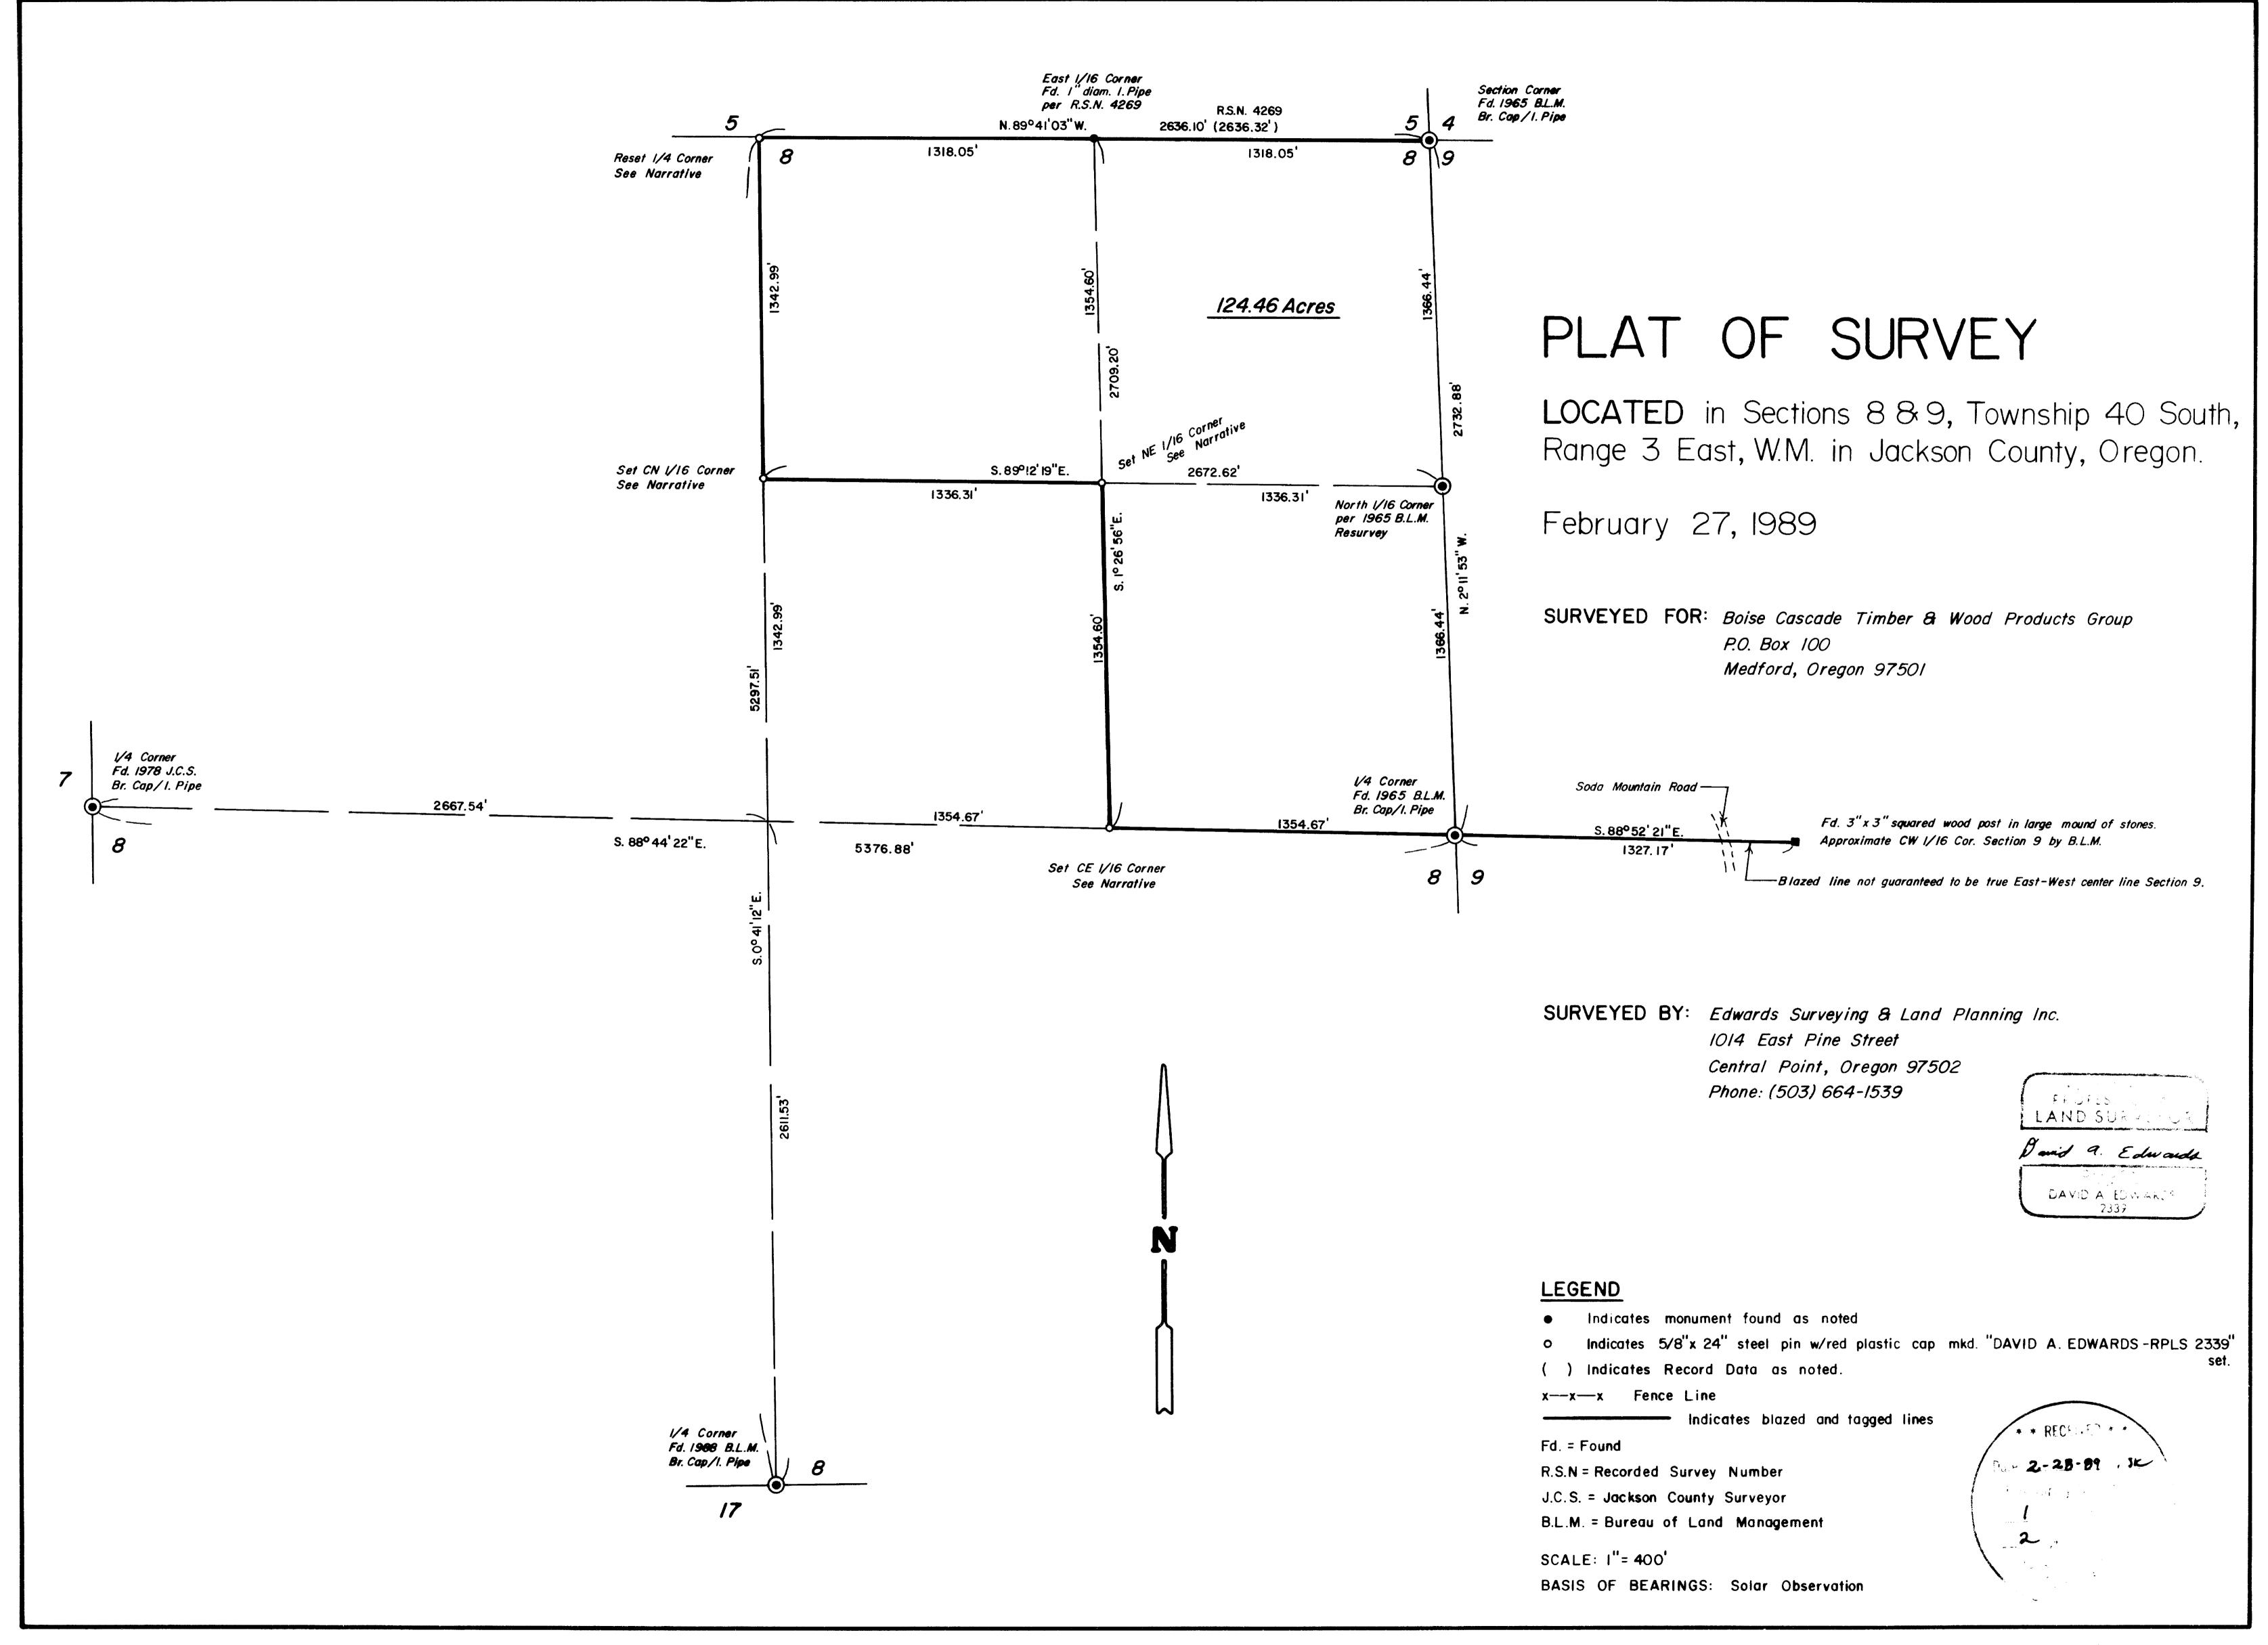

At the CE 1/16 Corner:

9" diam. D. Fir bears S.74°58'W., 24.9 ft. 8" diam. D. Fir bears N.24°52'W., 15.3 ft.

Monuments set on this survey consist of a 5/8" x 24" steel pin with red plastic cap mkd. "DAVID A. EDWARDS-RPLS 2339".

BASIS OF

BEARINGS:

A solar observation taken near the East 1/16

corner common to Sections 5 and 8.

EQUIPMENT:

Nikon NTD-4 Semi-automatic theodolite/E.D.M.

DATE

COMPLETED:

February 27, 1989

REGISTERED PROFESSIONAL LAND SURVEYOR

OREGON
DAVID A. EDWARDS
2339

* * RECEIVED * *

Date 2-28-89 Bys

This survey Consists of

____ sheet(s) Map

2 page(s) Narrative

JACKSON COUNTY
SURVEYOR

Edwards Surveying and Land Planning Inc. Registéred Land Surveyors 1014 East Pine St. Central Point, Oregon 07502 (503)664-1539

SURVEY NARRATIVE TO COMPLY WITH CHAPTER 209, PARAGRAPH 250, OREGON REVISED STATUTES

SURVEY FOR:

Boise Cascade Timber and Wood Products Group

P.O. Box 100

Medford, Oregon 97501

LOCATION:

In Sections 8 and 9, Township 40 South, Range 3

East of the Willamette Meridian in Jackson

County, Oregon.

PURPOSE:

To locate and monument the corners located in the NE 1/4 of Section 8 as shown on the attached map and to blaze, paint and place metal tags on trees along those boundary lines shown with a bold line on the attached map.

PROCEDURE:

A closed traverse was executed in and around Section 8 which generated a closure of about 1:14,000. This was then balanced and adjusted and short open traverses were run to tie in the South and West 1/4 corners of Section 8. The subdivision of the Section was then computed and the desired boundaries were traversed, monumented and marked as per client's direction and as shown on the accompanying plat.

With regard to the the line that was marked in Section 9, the found 3" x 3" squared wooden stake in stone mound must be considered as approximate and the line should not be construed to be the true East-West center line of Section 9. To perpetuate said approx. corner, the following trees were scribed "X-BT": 6" diam. Fir bears N.14°E., 25.56 ft. 10" diam Fir bears S.48°E., 42.55 ft.

The 1" diam. iron pipe reported set at the North 1/4 corner of Section 8 on Recorded Survey Number 4269 could not be found. I remonument this corner and from which the bearing trees scribed on said survey and found with healed blazes are as follows:

19" diam. B. Oak bears S.63°14'E., 91.50' to estimated lower face.

18" diam. W. Oak bears S.12°21'W., 78.2' to estimated upper face.

Bearing trees for the following corners set on this survey were scribed per the B.L.M. manual and are as follows:

At the CN 1/16 Corner: 6" diam. D. Fir bears N.37°30'W., 17.0 ft. (only tree available)

At the NE 1/16 Corner: 14" diam. D. Fir bears S.21°49'W., 8.3 ft. 6" diam. B. Oak bears N.79°49'W., 22.6 ft.