

CERTIFIED RECORD OF LAND CORNER MONUMENTATION

11613

History of original corner establishment:

The northwest one-sixteenth corner of section 27, Township 36 South, Range 3 East, Willamette Meridian, Jackson County, Oregon, was established by A. Gastadi, L.S. 928 while performing Jackson County Record Survey No. 8994, dated June, 1981.

DIAGRAM

T36S R3E
NW1/16 S27
1981
LS 928

Description of corner evidence found:

At corner point, I found a 2 1/2 inch diameter iron post with brass cap marked as shown, protruding 2 inches in mound of stone, and the following accessories:

An 18-inch diameter fir bears N.65°48'E., 34.85 feet distance, with fragmentary scribing visible.

An 11-inch diameter fir snag bears N.22°28' W., 29.70 feet distance, with fragmentary scribing visible.

Description of monument and accessories I establish to perpetuate the original location of this corner:

I stabilized the monument as needed and marked the following accessory:

A 23-inch diameter fir bears N.07°57'W., 23.10 feet distance, scribed NW1/16S27LS1071 BT.


April 14, 1989

HAROLD L. CENTER
REGISTERED PROFESSIONAL LAND SURVEYOR
OREGON CERTIFICATE NO. 1071



Office of COUNTY SURVEYOR, County of JACKSON, State of OREGON, I hereby certify that the within instrument was filed in this office for record on the ___ day of _____, 19__

_____ by _____
(County Official) (Deputy)

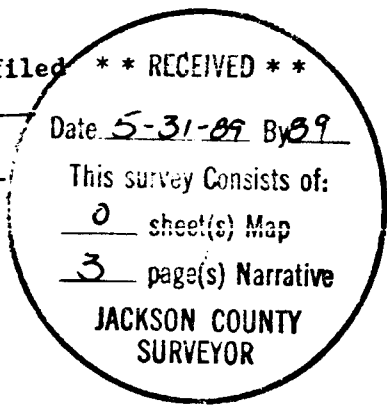

CERTIFIED RECORD OF LAND CORNER MONUMENTATION

11613

History of original corner establishment:

DIAGRAM

The center-east one sixteenth corner of section 27, Township 36 South, Range 3 East, Willamette Meridian, Jackson County, Oregon, was established by A. Castadi, L.S. 928 while performing Jackson County Record Survey No. 8994, dated June, 1981.

T36S R3E
E 1/16
C- -C
S27
1981
LS 928

Description of corner evidence found:

At corner point, I found a 2 1/2 inch diameter iron post with brass cap marked as shown, protruding 2 inches in mound of stone, and the following accessories:

A 19-inch diameter fir bears N.34°34'W., 9.30 feet distance, with fragmentary scribing visible.

A 13-inch diameter fir snag bears S.26°51'W., 25.10 feet distance, with fragmentary scribing visible.

Description of monument and accessories I establish to perpetuate the original location of this corner:

I stabilized the monument as needed and marked the following accessory:

A 13-inch diameter fir bears S.68°36'W., 39.30 feet distance, scribed CE1/16S27LS1071 BT.

April 14, 1989

HAROLD L. CENTER
REGISTERED PROFESSIONAL LAND SURVEYOR
OREGON CERTIFICATE NO. 1071



Office of COUNTY SURVEYOR, County of JACKSON,
State of OREGON, I hereby certify that the within instrument was filed
in this office for record on the ___ day of _____, 19__

_____ by _____
(County Official) (Deputy)

CERTIFIED RECORD OF LAND CORNER MONUMENTATION

11613

History of original corner establishment:

The north one-sixteenth corner of section 27, Township 36 South, Range 3 East, Willamette Meridian, Jackson County, Oregon, was established by A. Gastadi, L.S. 928 while performing Jackson County Record Survey No. 8994, dated June, 1981.

DIAGRAM

T36S R3E
N 1/16
S28 S27
1981
LS 928

Description of corner evidence found:

At corner point, I found a 2 1/2 inch diameter iron post with brass cap marked as shown, protruding 2 inches in mound of stone, and the following accessories:

A 13-inch diameter fir bears N.51°25'E., 20.03 feet distance, with fragmentary scribing visible.

A 10-inch diameter Chinquapin, dead but standing bears N.35°27'W., 70.72 feet, distance, with scribing N1/16S28 BT visible.

Description of monument and accessories I establish to perpetuate the original location of this corner:

I stabilized the monument as needed and marked the following accessory:

A 12-inch diameter fir bears S.29°46'W., 106.65 feet distance, scribed N1/16S28LS1071 BT.

April 14, 1989

HAROLD L. CENTER
REGISTERED PROFESSIONAL LAND SURVEYOR
OREGON CERTIFICATE NO. 1071



Office of COUNTY SURVEYOR, County of JACKSON, State of OREGON, I hereby certify that the within instrument was filed in this office for record on the ___ day of _____, 19__

_____ by _____
(County Official) (Deputy)