

**SURVEY IN BLOCK I, PAGE ADDITION
FOR
C. BROOKS & L. SMYLIE**

BY EDWARD A. MCGINTY
MEDFORD, OREGON
15 OCTOBER, 1958

SCALE 1" = 100'
O = 3/4" PIPE SET
X = CROSS SIDEWALK

REGISTERED
OREGON
LAND SURVEYOR

Edward A. McGinty

JULY 10, 1953
EDWARD A. MCGINTY
301


Survey No. 1162

Survey Narrative to comply with O.R.S. 209-205 and O.R.S. 209-120

Survey for: Mr. Brooks and Mr. Smylie

Survey by: Edward A. McGinty, L.S. 10/28/58

Found monuments on Jackson St. at Oak St and Woodstock. Found monument at Holly St. and Haven St. and intersection at Haven and Oak set by City references. Measured along Haven street from Oak to Holly and at a proportional distance found a spike, center line being on the South edge of spike, surveyed the East 50 feet of lot 9 and the lot line between lots 10 and 11, according to proportional distance.

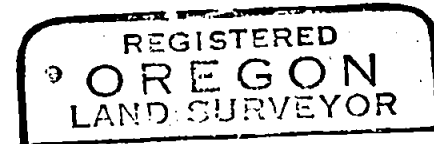

Edward A. McGinty

