


11652

**\*\* RECEIVED \*\***  
 Date 7/17/89 By SKZ  
 This survey Consists of:  
 / sheet(s) Map  
 / page(s) Narrative  
**JACKSON COUNTY**  
**SURVEYOR**

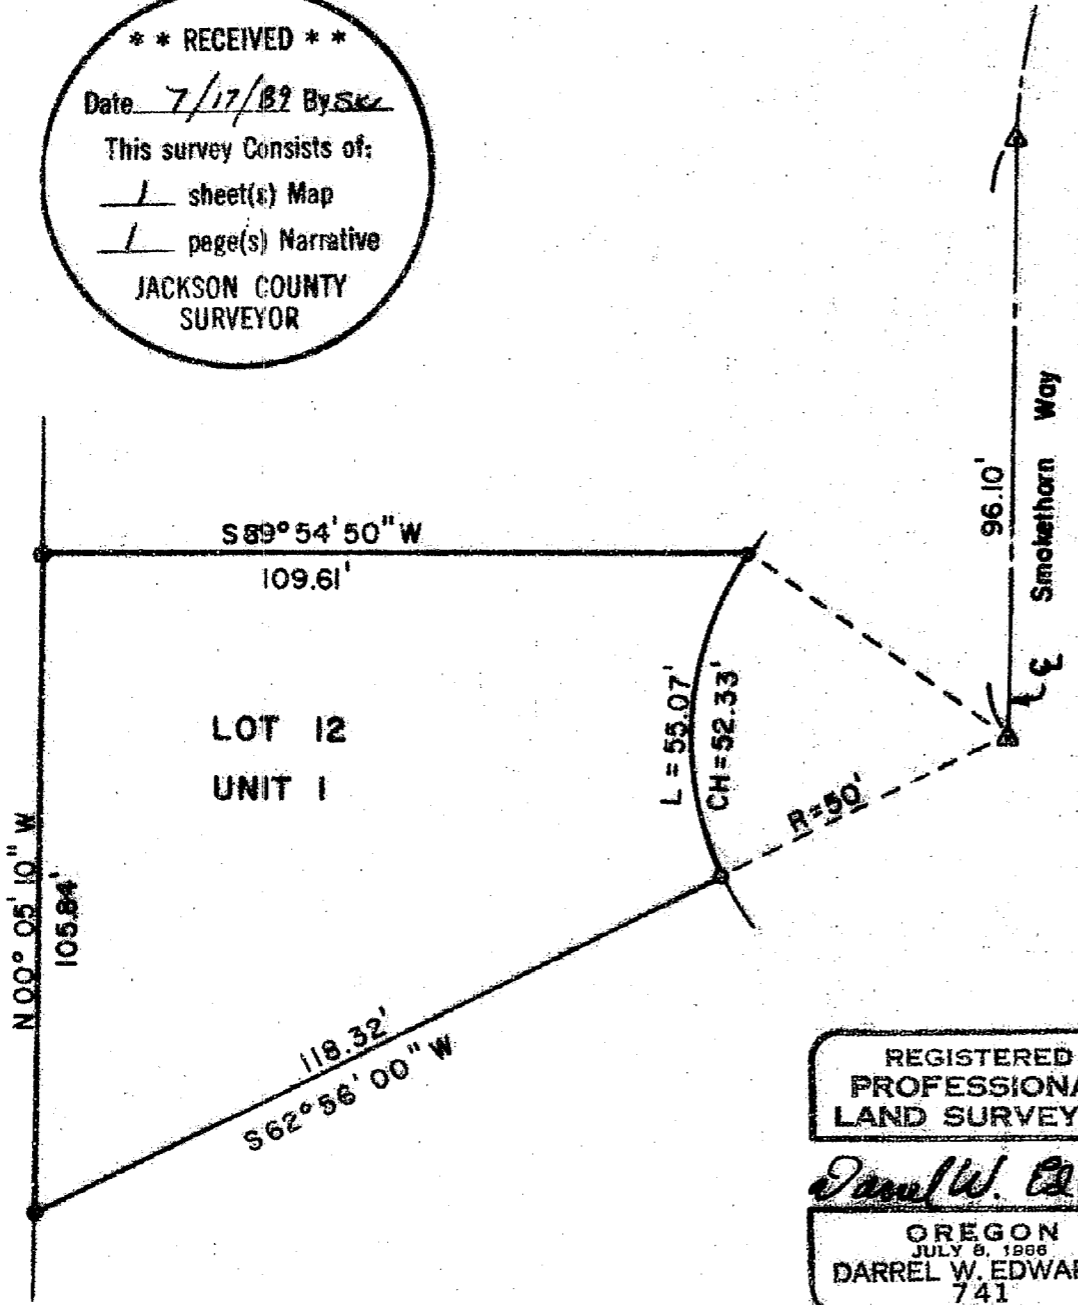

# PLAT OF SURVEY

LOCATED in Lot 12, Block 1, Countrywood  
 Subdivision Unit 1, SW 1/4, Sec. 8, T.37S., R.1W., W.M., City  
 of Medford, Jackson County, Oregon.

June 22, 1989

SURVEY FOR: *Anna Dunston*

SURVEY BY: *Edwards Surveying & Land Planning Inc.*  
 1014 East Pine St.  
 Central Point, Oregon 97502  
 Phone: 664-1539

### LEGEND

- ▲ Indicates centerline mon. found per subd. plat
  - Indicates 5/8" steel pin found
  - Indicates 5/8"x 24" steel pin w/plastic cap
- mkd. " D.W. EDWARDS P.L.S. 741" set

SCALE: 1" = 30'

BASIS OF BEARINGS: Recorded plat at Countrywood Unit 1

REGISTERED  
 PROFESSIONAL  
 LAND SURVEYOR

*Darrel W. Edwards*

OREGON  
 DARREL W. EDWARDS  
 741

11652

SURVEY NUMBER 11652

Edwards Surveying and Land Planning Inc.  
Registered Land Surveyors  
1014 East Pine St.  
Central Point, Oregon 97502  
(503)664-1539

SURVEY NARRATIVE TO COMPLY WITH CHAPTER 209, PARAGRAPH 250,  
OREGON REVISED STATUTES

SURVEY FOR: Anna Dunston

LOCATION: In Lot 12, Block 1, COUNTRYWOOD SUBDIVISION  
UNIT 1, SW 1/4 Section 8, T. 37 S., R. 1 W.,  
W.M., City of Medford, Jackson County, Oregon.

PURPOSE: To find or set the property corner monuments of  
said Lot 12, Block 1.

PROCEDURE: Found all original corner monuments except the  
Southeast corner. Reset said monument utilizing  
the monument at the Southwest corner and  
existing center line monuments. Set a 5/8" x  
24" steel pin with plastic cap mkd. "DW  
EDWARDS-PLS 741".

BASIS OF  
BEARINGS: Recorded Plat of COUNTRYWOOD SUBDIVISION UNIT 1

EQUIPMENT: Nikon NTD-4 Semi-automatic theodolite/E.D.M.

DATE  
COMPLETED: June 22, 1989

REGISTERED  
PROFESSIONAL  
LAND SURVEYOR

*Darrel W. Edwards*

OREGON  
DARREL W. EDWARDS  
741

\*\* RECEIVED \*\*

Date 7/17/89 By SK

This survey Consists of:

1 sheet(s) Map

1 page(s) Narrative

JACKSON COUNTY  
SURVEYOR