

LEGEND

- FOUND BLM BRASS CAP & BT'S PER BLM UNRECORDED 1966 CADASTRAL SURVEY
- CALCULATED CORNER POSITION
- SET 5/8" x 30" REBAR WITH YELLOW PLASTIC CAP MARKED "TEMPLIN RLS 2359"
- () BLM 1966 RECORD
- TRUE LINE BLAZED AND PAINTED RED

BASIS OF BEARING: BLM'S BEARING BETWEEN WEST 1/4 CORNER AND CENTER 1/4 CORNER OF SECTION 30.

** RECEIVED **

Date: 7-1-89 By: [Signature]

This survey consists of
 - 1 sheet of map
 - 2 sheets of narrative

RICHARD G. TEMPLIN
 JACKSON COUNTY
 SURVEYOR

RICHARD TEMPLIN LAND SURVEYING
 2042 SANDRA PL. 776-0991 MEFORD, OREGON

PLAT OF SURVEY
 LOCATED IN
 SECTION 30, T. 39 S., R. 1 W., W. M., JACKSON COUNTY, OREGON

SURVEY FOR: MEDCO CORP. & MT. FIR CO. MEDFORD; MURPHY OREGON

DATE: JULY 12, 1989

SCALE: 1" = 500'

RICHARD G. TEMPLIN
 JACKSON COUNTY
 SURVEYOR

[Signature]

RICHARD G. TEMPLIN
PROFESSIONAL LAND SURVEYOR



2042 Sandra Pl.
Medford, Oregon 97504
(503) 776-0991 • 474-7720

11664

Returning to the CE 1/16 corner I thence run South 00° 32'36" East, 2623 69 feet to the calculated position of the East 1/16 corner on the South line of Section 30 which I set a 5/8" rebar, from which I scribed the following bearing trees:

A Ponderosa Pine 18" diameter bears North 25° East, 30.9 feet, scribed "E 1/16S 30" "BT".
A Black Oak 14" diameter bears South 75° East, 5.3 feet, scribed "E 1/16S31" "BT".

True line was blazed, painted and Medco boundary tags posted.

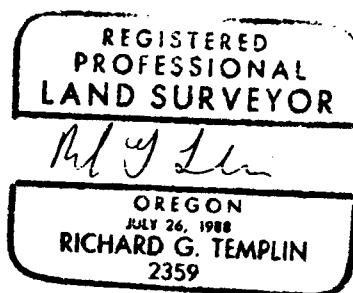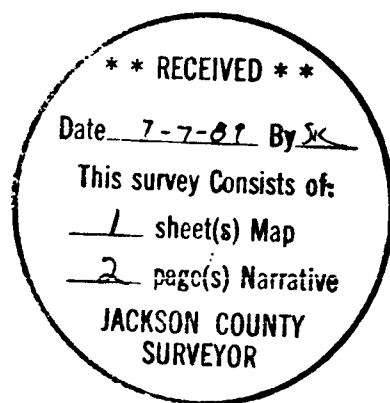

RICHARD G. TEMPLIN
PROFESSIONAL LAND SURVEYOR

2042 Sandra Pl.
Medford, Oregon 97504
(503) 776-0991 • 474-7720

SURVEY NO. **11664**

SURVEY FOR: Medford Corporation and Mountain Fir Lumber
North Pacific Highway Medford, Oregon and
Williams Hwy, Grants Pass, Oregon

Location: Section 30, Township 39 South, Range 1 West,
Willamette Meridian, Jackson County, Oregon.

Purpose: To monument the Center East 1/16 Corner and
the East 1/16 Corner between Sections 30 and
31 ; to mark true line between the East 1/16
Corner between Sections 19 and 30 to the
Center East 1/16 Corner to the East 1/16
between Sections 30 and 31.

Date: July 12, 1989

**Basis of
Bearing:** Based upon BLM's bearing between the West 1/4
Corner to the Center 1/4 Corner of Section 30.

Procedure: Utilizing a Wild T-2, Wild T-16, Mac 1E and a
Red 2L EDM, I tied the West, South and Center
1/4's in, also the NE and SE section corners
and the East 1/16 corner between Sections 19
and 30.
In 1986 BLM did a Cadastral survey on
Section 30, I obtained a copy of their
work plat and used it to calculate corner
positions that were not tied into on this
survey. The results are shown on accompanying
plat.
The East 1/16 corner on the North line of
Section 30 was excepted and used. I calculated
the positions for the Center East 1/16 and set
a 5/8" rebar, from which I scribed the
following bearing trees:
A Douglas Fir 9" diameter bears South 64°
West, 25.6 feet, scribed "CE1/16" "BT".
A Ponderosa Pine 24" diameter bears South 45°
East, 24.1 feet, scribed "CE1/16" "BT".
I then ran North 01°19'34" West, 2635.30 feet
to the BLM's East 1/16 corner on the North
line of Section 30 and closed.