


SURVEY NO.
1247 & 5648

SURVEY NO.
11436

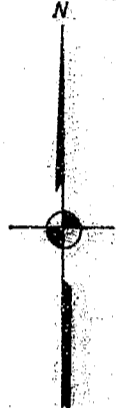

LEGEND:

- = SET 5/8" IRON PIN WITH PLASTIC CAP
MARKED FRIAR PLS 961
- ⊗ = FOUND 3/4" DIA. IRON PIPE
- ⊙ = FOUND CO. SURVEYOR'S MONUMENT AS NOTED
- ⊙ = FOUND 5/8" IRON PIN

REGISTERED
PROFESSIONAL
LAND SURVEYOR

Larry J. Friar
OREGON
JULY 16, 1971
LARRY J. FRIAR
961

MAP OF SURVEY
FOR
GLEN R. HOBBS

** RECEIVED **
Date 7-20-89 by SK
This survey consists of:
1 sheet(s) Map
1 page(s) Narrative
JACKSON COUNTY
SURVEYOR

LOCATED IN THE S.W. 1/4 OF SECTION 25, T.37S.,
R.2 W., W.M., JACKSON CO., OREGON.
DATE: JULY, 1989 SCALE: 1" = 100'
BASIS OF BEARINGS: SURVEY NO. 8069
SURVEYED BY: L. J. FRIAR & ASSOCIATES
MEDFORD, OREGON

FOUND BRASS DISK
IN CONCRETE

37 2W 25CB TL 5200 & 5600

Survey No. 11670

Survey Narrative To Comply With O.R.S. 209.250

Survey For: Glen Hobbs
1810 West Main
Medford, OR 97501

Location: The S.W. 1/4 of Sec. 25, T.37 S., R.2 W., W.M.,
Jackson County, Oregon.

Purpose: To survey and monument the corners of the client's
property.

Procedure: Using found monuments as control, I set pins as
shown on the attached map.

Basis of Bearing: Survey No. 8069

Date: July 17, 1989

T37S R2W SEC25CB TL5200 & 5600

Larry J. Friar
L.J. Friar & Associates
Consulting Land Surveyors
717 West 10th, Suite 1
Medford, OR 97501
(503) 772-2782

