

* * RECEIVED * *

Date 8-9-89 By JL

This survey consists of

1 sheet(s) Map

1 page(s) Narrative

JACKSON COUNTY
SURVEYOR

PLAT OF SURVEY

LOCATED in the SW 1/4 of Section 34,
T. 33 S., R. 1 E., W.M. Jackson County, Or.

July 26, 1989

SURVEYED FOR: *Gayle Clogston*
6150 Tolo Rd.
Central Point, OR. 97502

SURVEYED BY:
Edwards Surveying and Land Planning Inc.
1014 East Pine Street
Central Point, Oregon 97502
Phone: (503) 664-1539

LEGEND

- Indicates 1/2" diam. I. Pipe found per R.S.N. 1144 except where noted.
 - o Indicates 5/8"x24" steel pin w/plastic cap mkd. "DW EDWARDS-PLS 741" sat.
 - () Denotes Record Data per R.S.N. 1144 unless noted otherwise.
 - x-x-x-x-x Fence Line
- SCALE: 1" = 100'
BASIS OF BEARINGS: R.S.N. 1144
- R.S.N. = Recorded Survey Number

**REGISTERED
PROFESSIONAL
LAND SURVEYOR**

Darrel W. Edwards

**OREGON
JULY 8, 1989
DARREL W. EDWARDS
741**

SURVEY NUMBER 11681

Edwards Surveying and Land Planning Inc.
Registered Land Surveyors
1014 East Pine St.
Central Point, Oregon 97502
(503)664-1539

SURVEY NARRATIVE TO COMPLY WITH CHAPTER 209, PARAGRAPH 250,
OREGON REVISED STATUTES

SURVEY FOR: Gayle Glogston
6150 Tolo Road
Central Point, Oregon 97502

LOCATION: In the SW 1/4 of Section ~~33~~³⁴, Township ~~34~~³³ South,
Range 1 ~~West~~^{East}, Willamette Meridian, Jackson
County, Oregon.



PURPOSE: To locate and monument the boundaries of that
tract of land described in Document Number
89-09475, Official Records.

PROCEDURE: Utilized for control monuments of record per
Recorded Survey Number 1144 and deed record
information found in the description contained
in the above noted document. A closed traverse
was executed to set monuments as shown on the
attached plat and which consist of 5/8" x 24"
steel pins with yellow plastic caps mkd. "DW
EDWARDS-PLS 741".


BASIS OF
BEARINGS: Recorded Survey Number 1144.

EQUIPMENT: Nikon NTD-4 Semi-automatic theodolite/E.D.M.

DATE
COMPLETED: July 26, 1989

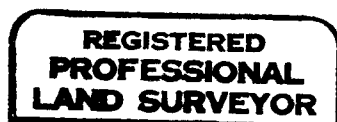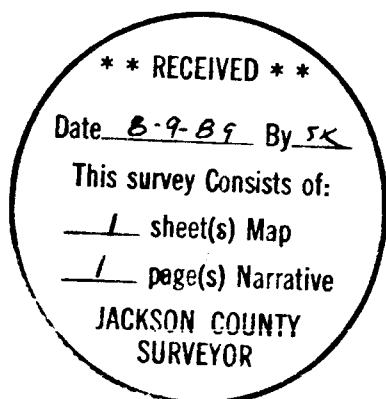

Darrel W. Edwards

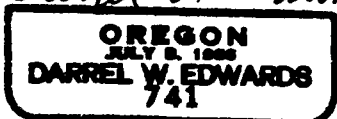

~~T33-1E~~ 34C Tax Lot 501

T33-1E

092