

REGISTERED
 OREGON
 LAND SURVEYOR

Edward A. McGinty

JULY 10, 1953
 EDWARD A. MCGINTY
 301

SURVEY IN BLK. 2 WEST WALNUT PARK ADD.
 FOR
 B. ELLIOTT & MRS. MC INTYRE

BY EDWARD A. MCGINTY
 MEDFORD, OREGON
 OCTOBER 30, 1958



SCALE 1"=60'
 ● = CONC. MON. FD.
 ○ = 3/4" PIPE SET
 ● = 5/8" PIN SET
 X = CROSS ON CONC.

Survey No. 1170


Survey Narrative to comply with O.R.S. 209-120 and O.R.S. 209-205

Survey for: Bert Elliott and Mrs. E. McIntyre

Survey by : Edward A. McGinty, L.S. 11/15/58

PRECEDENCE OF SURVEY:

Found a 3/4 inch iron pipe, being at the northwest corner of West Walnut Park Addition as shown. From the center line monument at Chestnut and West Main and 30 feet from the northwest corner of West Walnut Park Addition, determined the center line of West Main and the North line of Block 1 and 2 of West Walnut Park Addition. Found discrepancy in the center line of West Main Street by using Sub-division North of Main street which should control the North line of Main St. and monuments at Chestnut and the Northwest corner of West Walnut Park Addition should be held for control to the south. Measured between the center line of Lewis street and the center line of Chestnut and at a proportional distance determined the center line of Jeanette, and from the monuments shown on the map. At a proportional distance and record depth surveyed lots as shown.

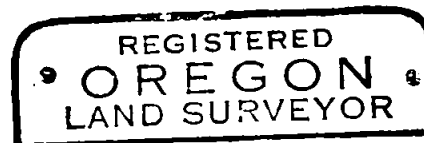

Edward A. McGinty

