

LEGEND

○ SET 5/8" x 30" REBAR WITH YELLOW PLASTIC CAP MARKED "TEMPLIN RLS 2359"

● FOUND 5/8" IRON ROD WITH YELLOW PLASTIC CAP MARKED "FRIAR PLS 961"

() INDICATES RECORD PER R.S. NO. 9799

() INDICATES RECORD PER DEED

R.S. RECORDED SURVEY

BEARINGS BASED UPON THE SOUTH LINE OF SECOND AVE. PER R.S. NO. 9799

TL 2400 36-3W-21AA

RECEIVED
Date: 9-15-89 By: [Signature]
This survey consists of:
1 sheet(s) Map
1 page(s) Narrative
JACKSON COUNTY SURVEYOR

REGISTERED PROFESSIONAL LAND SURVEYOR
RICHARD G. TEMPLIN
2359

RICHARD TEMPLIN LAND SURVEYING
2042 SANDRA PL. 776-0991 MEDFORD, OREGON
PLAT OF SURVEY
LOCATED IN
LOT 5, BLOCK 2, RIVERSIDE ADDITION TO GOLD HILL, OREGON
NE 1/4 OF SECT. 21, T.36S., R.3W., W.M., JACKSON COUNTY, OREGON
SURVEY FOR: Mr. Robert Chaney
Livermore, Calif.
DATE: SEPTEMBER, 1989
SCALE: 1" = 100'

RICHARD G. TEMPLIN
PROFESSIONAL LAND SURVEYOR
2042 Sandra Pl.
Medford, Oregon 97504
(503) 776-0991 • 474-7720

SURVEY NO. **11722**

Survey For: Mr. Robert Chaney
Laverne, California



Location: Lot 5, Block 2, Riverside Addition to Gold Hill, NE 1/4 of Section 21, Township 36 South, Range 3 West, Willamette Meridian, Jackson County, Oregon.

Purpose: To monument the deeded corners of O.R. 89-16966 as shown on the accompanying plat.

Date: February 2, 1988

Basis of Bearing: South Right of Way line of Second Avenue per Recorded Survey No. 9799.

Procedure: Utilizing a Wild T-16 and Mac 1 EDM, tied found monuments set on Recorded Survey No. 9799 . I then calculated deed positions and set monuments as shown on accompanying plat.

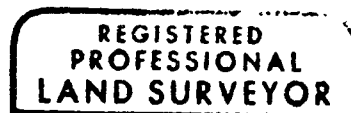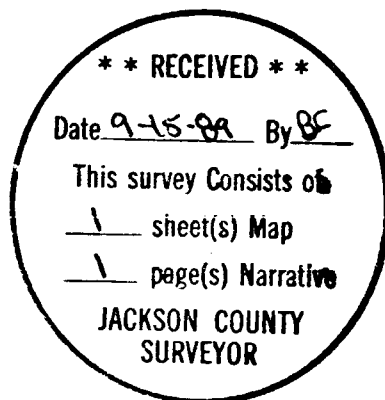

Richard G. Templin

