


SURVEY NO. 7078 & 6229

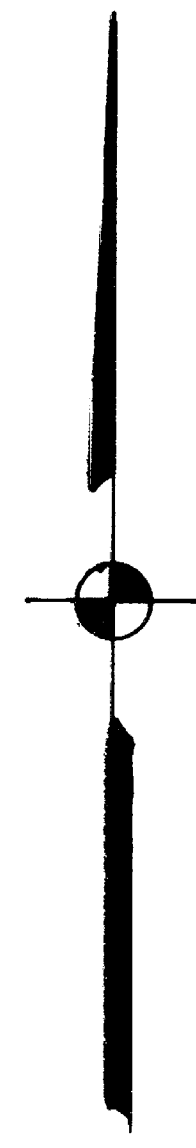

LEGEND:

- ⊙ = FOUND COUNTY SURVEYOR'S BRASS CAPPED PIPE
- = FOUND 5/8" IRON PIN WITH PLASTIC CAP MARKED FRIAR PLS 961
- = SET 5/8" IRON PIN WITH PLASTIC CAP MARKED FRIAR PLS 961

REGISTERED  
**PROFESSIONAL  
 LAND SURVEYOR**  
*Larry J. Friar*  
 OREGON  
 JULY 16, 1971  
 LARRY J. FRIAR  
 961

\*\*\* RECEIVED \*\*\*  
 Date 11-21-89 By SLK  
 This survey consists of:  
 - 1 sheet(s) Map  
 - 1 page(s) Narrative  
 JACKSON COUNTY  
 SURVEYOR

MAP OF SURVEY  
 FOR  
**JAMES J. & CHARLOTTE M. HERRELL**

LOCATED IN THE N.W. 1/4 OF SECTION 32, T.34 S., R.1 E.,  
 W.M., JACKSON COUNTY, OREGON.  
 SCALE: 1" = 200' DATE: OCTOBER, 1989  
 BASIS OF BEARING: SURVEY NO. 6229  
 SURVEYED BY: L.J. FRIAR & ASSOCIATES P.C.  
 MEDFORD, OREGON

Survey No. 11800

Survey Narrative To Comply With O.R.S. 209.250

Survey For: JAMES J. AND CHARLOTTE M. HERRELL  
7075 Buttte Falls Highway  
Eagle Point, OR. 97524

Location: N. W. 1/4 Section 32, Township 34 South,  
Range 1 East, Willamette Meridian, Jackson  
County, Oregon.

Purpose: To Survey, Monument and mark the Boundary  
of the Clients Property.

Procedure: Portions of the Property Boundary were previously  
Surveyed and Monumented during Surveys No. 6229 and  
7078. The Corners established by those Surveys were  
located and used for control in establishing the  
West line of the Property.

Basis of Bearing: Survey No. 6229

Date: November 14, 1989.

T.34 S. , R. 1 E., SEC. 32, T.L. 200

REGISTERED  
PROFESSIONAL  
LAND SURVEYOR

*Larry J. Friar*  
OREGON  
JULY 16, 1971  
LARRY J. FRIAR  
961

Larry J. Friar  
L.J. Friar & Associates P.C.  
Consulting Land Surveyors  
717 West 10th, Suite 1  
Medford, OR 97501  
(503) 772-2782

\*\* RECEIVED \*\*  
Date 11-21-89 By SK  
This survey Consists of  
1 sheet(s) Map  
1 page(s) Narrative  
JACKSON COUNTY  
SURVEYOR