

1181

1181

Survey for Chas. Brooks, Medford Oregon.
 Property on Crestbrook Road, in D.L.C. 51.T.37S.R.1W.(W.M.) Jackson County, Oregon.

Nov. 1958 Scale 1" = 100'

N.E. Cor. D.L.C. 50

221.1



• 5/8" bars set

© Monuments & corners used for control.

Center found

REGISTERED
 OREGON
 LAND SURVEYOR

L. N. Dow

MAY 6, 1949
 L. N. DOW
 251

MODOC AVE

R20
 34" pipe f.

bar found where road turns south

CRESTBROOK ROAD

30

350.00

N 89°42' E

257.33

130

60

North

100.0

130

South

100.0

S 89°42' W

North

100.0

65

South


100.0

65

30

30

ELLEDALE

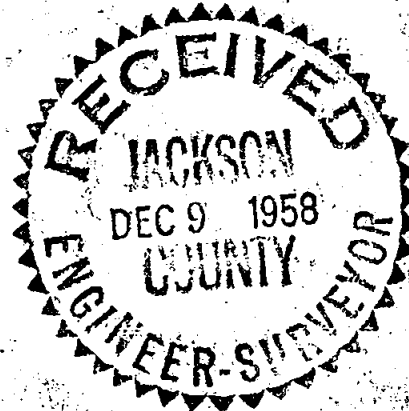

1181

1181

Written narrative to accompany plat for Survey No.

Survey for Mr. Charles Brooks, Medford, Oregon.

Purpose of survey to stake lots and prepare descriptions.

Location, in D.L.C. NO. 51, T. 37S, R 1 W. Jackson County, Oregon.

Procedure:

Having the Northeast corner of D.L.C. No. 50, a center at the intersection of Ellendale and Crestbrook Road, and the point of intersection bar at the angle in Crestbrook where it turns to the south, we then located the center of Modoc Avenue where it intersects Crestbrook, and leaving a 60 foot opening for a possible future street we staked a lot on either side as shown on the plat, setting 5/8" iron bars at the corners of each.

REGISTERED
OREGON
LAND SURVEYOR

L. N. Dow

MAY 6, 1949
L. N. DOW
251

