


MAP of SURVEY

Located in Lot 1, part of Lot 2, and part of Lot 5, Block 10, in the Northeast quarter of Section 32, Township 37 South, Range 2 East of the Willamette Meridian, City of Jacksonville, Jackson County, Oregon.

for STUART V. HINSON

Basis of Bearing: ϵ 5th Street as per filed survey no. 1783
 ○ Found monuments as described
 ● Set 5/8" x 24" iron pin with yellow plastic cap marked "FARBER LS 2189"
 ✱ Set 5/8" x 24" iron pin witness corner with yellow plastic cap marked "FARBER LS 2189"
 Scale: 1" = 40'
 Date: November 7, 1989

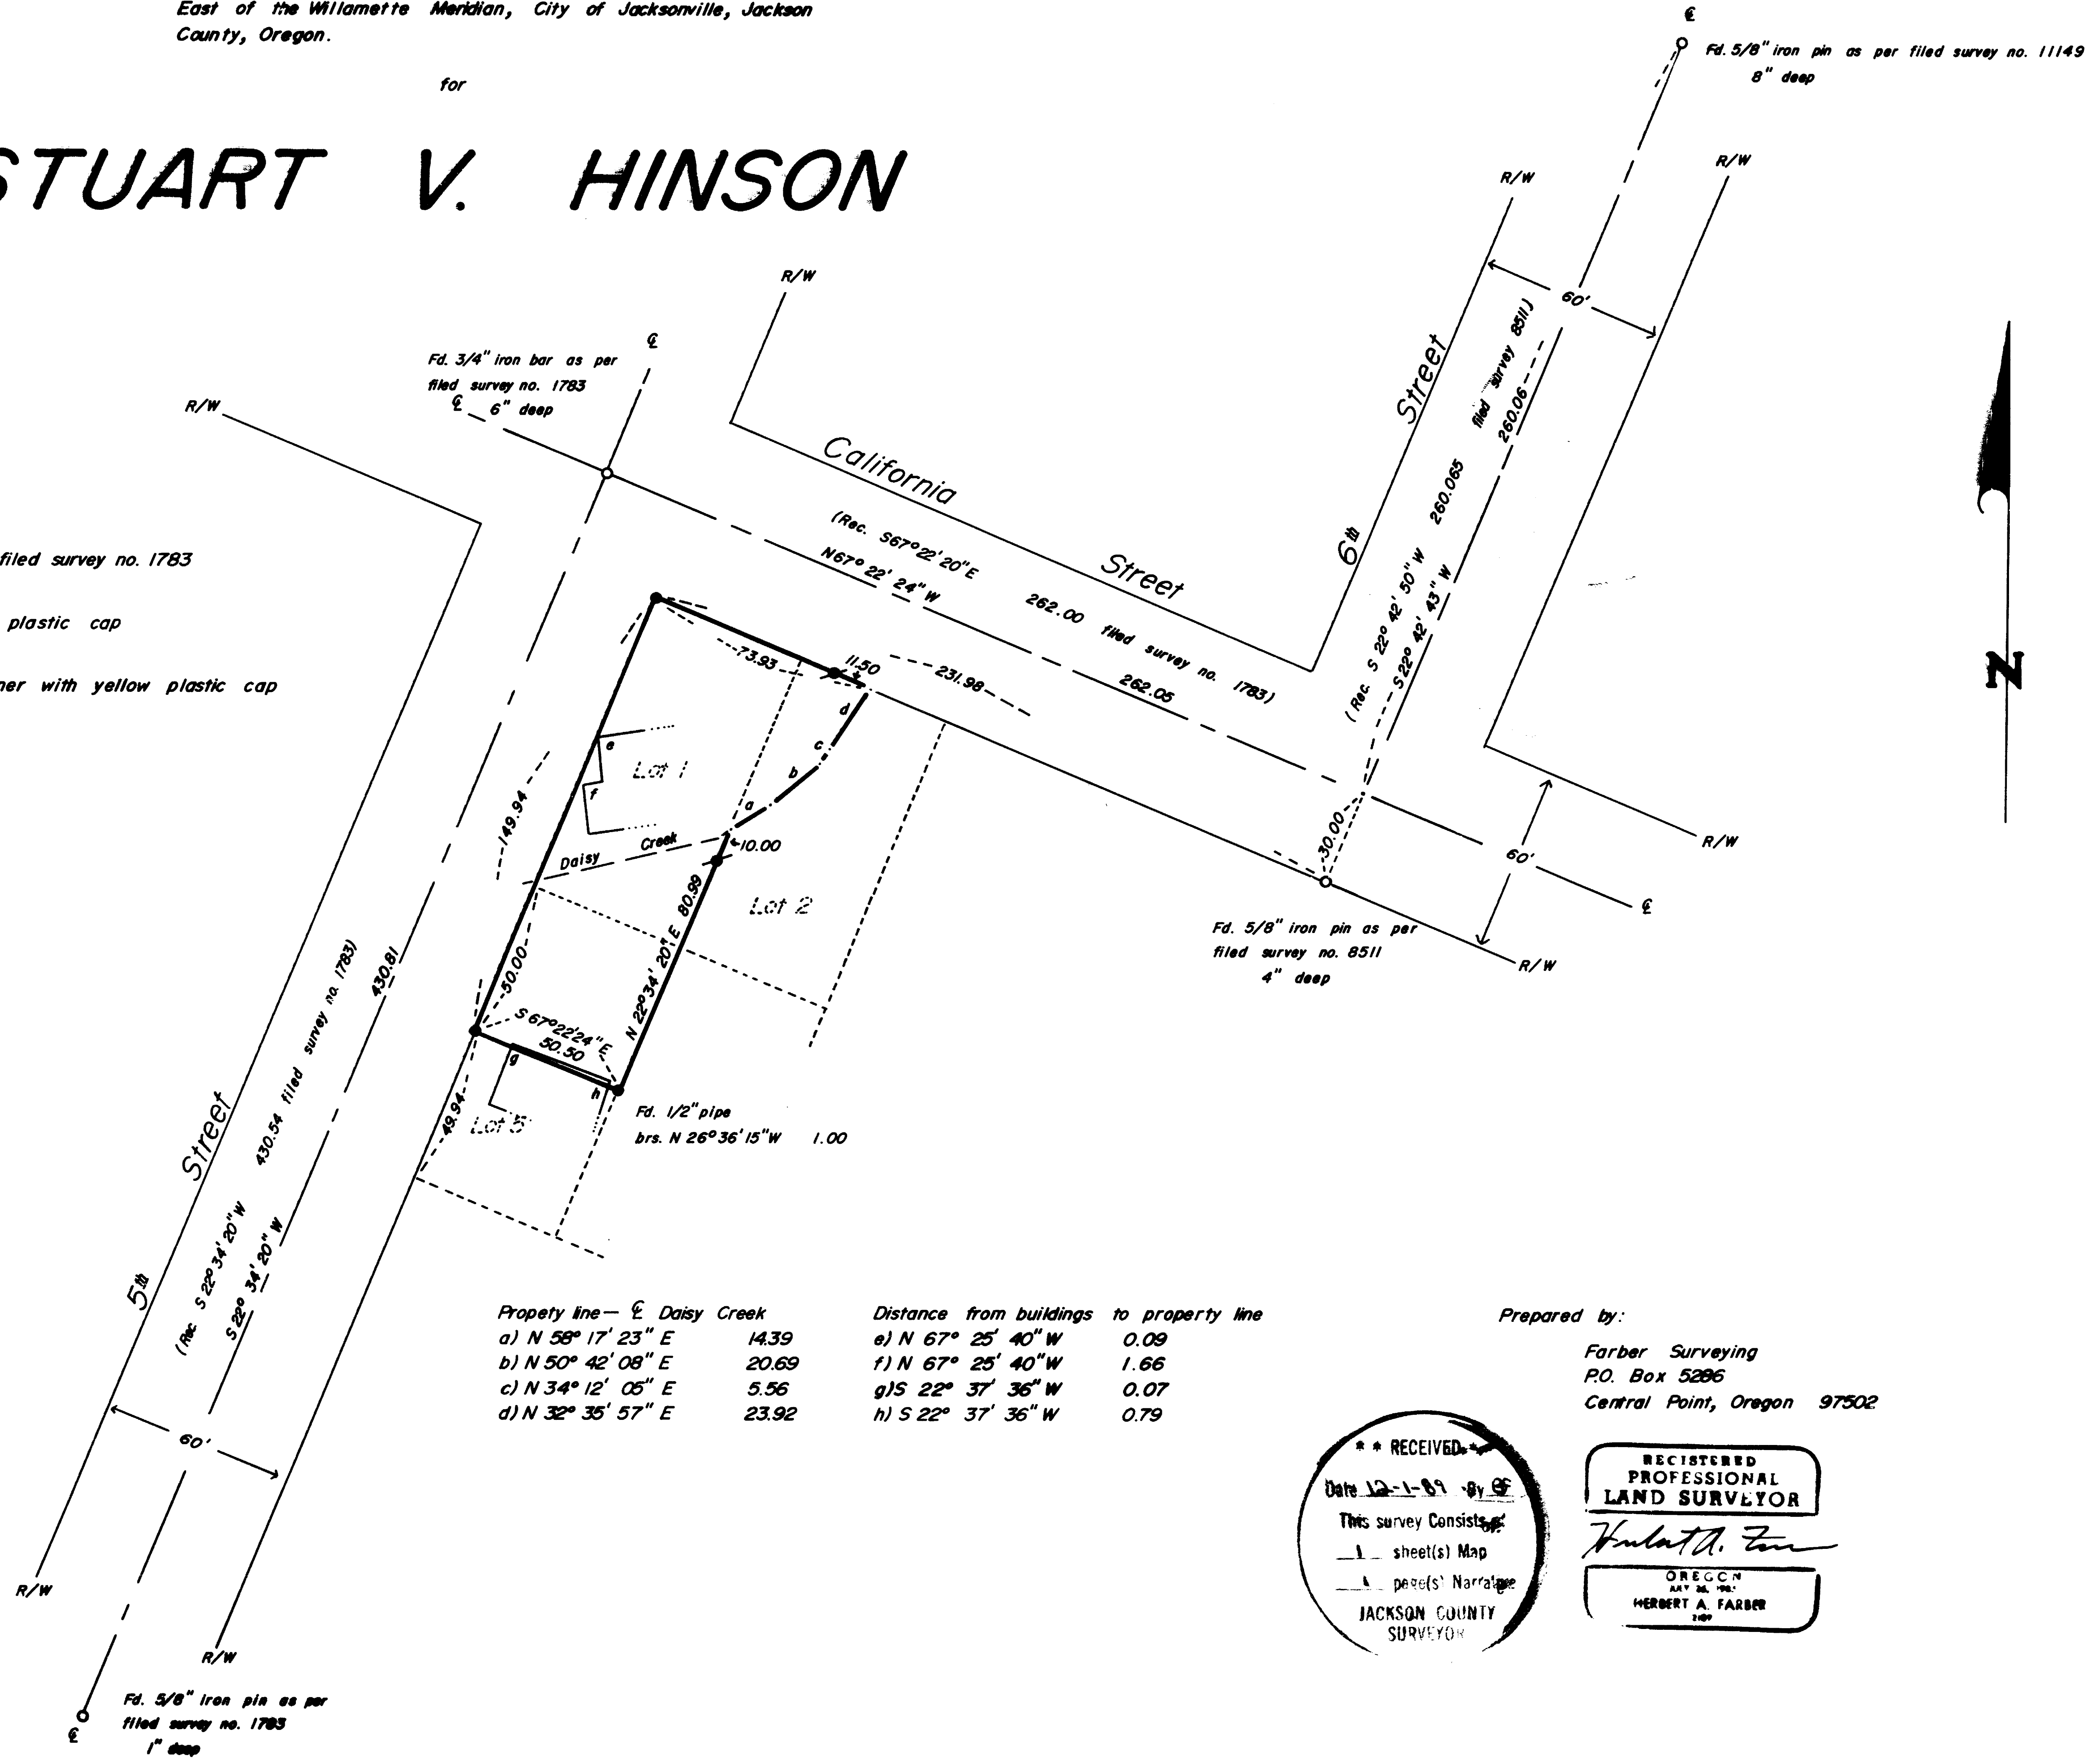

TL 8700

Survey No. 11811

SURVEY NARRATIVE TO COMPLY WITH O.R.S. 209.250

Survey for: Stuart V. Hinson
4020 Little Applegate Road
Jacksonville, Oregon 97530

Location: Located in Lot 1, part Lot 2 and part Lot 5
Block 10 of the original town plat, in the
northeast quarter of Section 32, Township 37
South, Range 2 West of the Willamette
Meridian, City of Jacksonville, Jackson
County, Oregon.

Purpose: To monument Tax Lot 8700 as per Instrument No.
80-18258 of the Official Records of Jackson
County, Oregon.

Procedure: I tied all of the controlling monuments of
record for Block 10. I then computed Block 10
and established monuments on the corners of
Tax Lot 8700, with the exception of those
corners which fall in Daisy Creek which were
witnessed.

Bearing is based on the center line of 5th
Street as per filed survey no. 1783.

Surveyed by: Farber Surveying
P.O. Box 5286
Central Point, Oregon 97502

Date: November 7, 1989

REGISTERED
PROFESSIONAL
LAND SURVEYOR

Herbert A. Farber

OREGON
JULY 26, 1935
HERBERT A. FARBER
2189

** RECEIVED **
Date 12-1-89 By RF
This survey Consists of:
1 sheet(s) Map
1 page(s) Narrative
JACKSON COUNTY
SURVEYOR