

BASIS OF BEARINGS IS  
THE N-S C. OF SEC. 3  
PER SURVEY NO. 4393

**RECORD of SURVEY**  
LOCATED IN: NW 1/4, SEC. 3, T. 34 S., R. 1 W.,  
WILL. MER., JACKSON COUNTY, OREGON  
SEPT. 1989 SCALE: 1"=100'

SURVEYED FOR: RAY FLOWERS



**LEGEND**

- = FOUND MON. AS SHOWN
- = SET 5/8" x 24" REBAR W/CAP MKD. "ANDREWS PLS 1626"

**SURVEYED BY**

JAMES ANDREWS  
304 S. HOLLY  
MEDFORD, OREGON 97501  
PH. 773-8866

34 - 1W - 3B T.L. 400

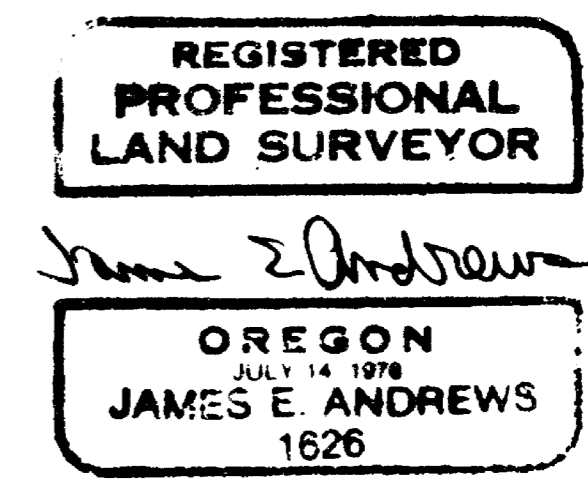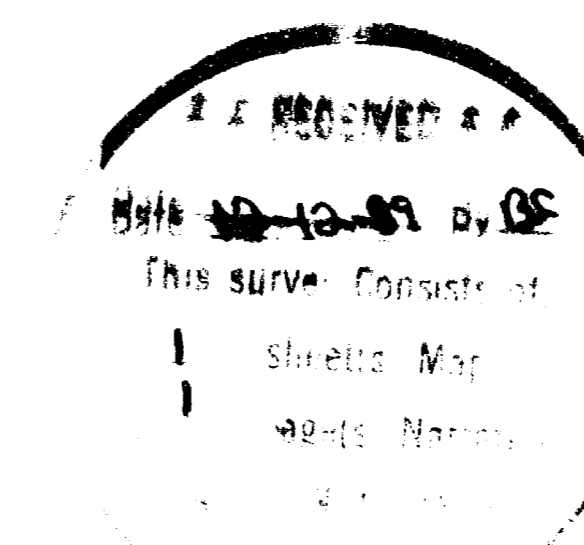

SURVEY NO. 11828

SURVEY NARRATIVE TO COMPLY WITH O.R.S. 209.250

DATE: September, 1989

SURVEY FOR: Ray Flowers  
P.O. Box 1049  
Shady Cove, Oregon 97539

LOCATION: Northwest Quarter of Section 3, Township 34 South, Range  
1 West, Willamette Meridian, Jackson County, Oregon.

PURPOSE: To survey and monument the parcel shown on the attached  
map.

PROCEDURE: I located the North Quarter corner of of Section 3 and the  
point on the north-south centerline set in Survey no.  
4393. I located the highway rightway per monuments found  
and the legal description. The legal description begins  
at the southeast corner of Govt. Lot 6, which is a point  
on the meander line that was not established in the the  
original survey. I took the intersection of the north-south  
section centerline and the north bank of the River to be  
the point of beginning and set monuments accordingly as  
shown on the attached map.

BASIS OF BEARINGS: The Basis of Bearings is the north-south centerline  
of Section 3 per Survey no. 4393.

SURVEYED BY: James Andrews  
304 South Holly  
Medford, Oregon 97501

