


FD BRASS CAP CLOSING CORNER PER JACKSON COUNTY REESTABLISHMENT BOOK, PAGE 61  
 TRUE CLOSING CORNER POSITION PER R.S. NO. 7877

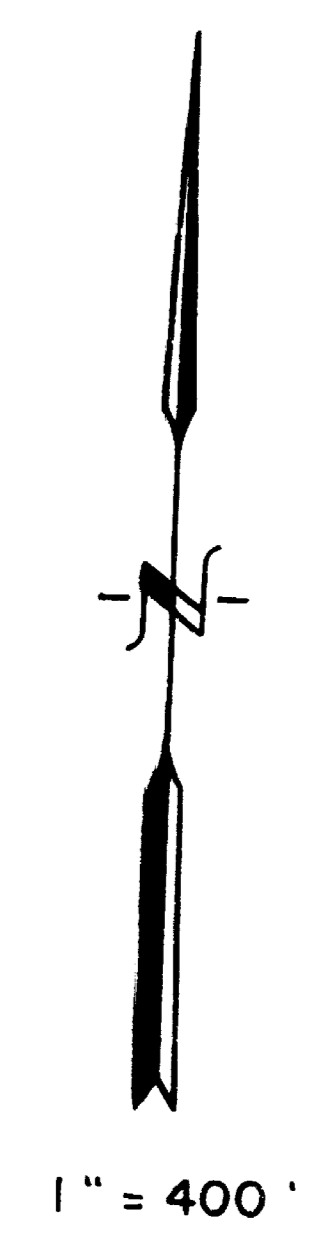

- FOUND JACKSON COUNTY BRASS CAP MONUMENT PER JACKSON COUNTY REESTABLISHMENT BOOK
  - FOUND OREGON STATE BOARD OF FORESTRY 1 1/2" GALVANIZED IRON PIPE WITH 3" BRONZE CAP PER RECORDED SURVEY NO. 7877
  - SET 5/8" x 30" REBAR WITH YELLOW PLASTIC CAP MARKED "TEMPLIN 2359"
  - ( ) RECORD PER RECORDED SURVEY NO. 7877
  - INDICATES LINE BLAZED AND PAINTED RED
- BEARINGS BASED UPON RECORDED SURVEY NO. 7877

12-26-89  
 1  
 2

RICHARD TEMPLIN LAND SURVEYING 2042 SANDRA PL. 776-0991 MEDFORD, OREGON	
<b>PLAT OF SURVEY</b> LOCATED IN SECTION 36, T.38S., R.2W., W.M., JACKSON COUNTY, OREGON	
SURVEYED FOR: BOISE CASCADE CORP. P.O. BOX 100 MEDFORD, OREGON	DATE: DEC. 1989 SCALE: 1" = 400'

**RICHARD G. TEMPLIN**  
PROFESSIONAL LAND SURVEYOR  
2042 Sandra Pl.  
Medford, Oregon 97504  
(503) 776-0991 • 474-7720

11852

A 16" Cedar, bears N24°47'E, 10.65 feet,  
scribed " NE1/16S36" "BT".


A 6" Douglas Fir, bears S16°19'E, 25.30 feet,  
scribed " NE1/16S36" "BT".

I then ran true line between monuments as shown  
on accompanying plat.

REGISTERED  
PROFESSIONAL  
LAND SURVEYOR

*R. G. Templin*

OREGON  
JULY 26, 1988  
RICHARD G. TEMPLIN  
2359

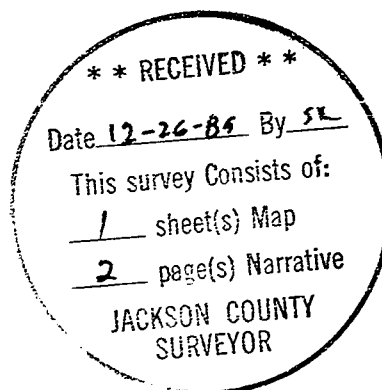

**RICHARD G. TEMPLIN**  
**PROFESSIONAL LAND SURVEYOR**  
2042 Sandra Pl.  
Medford, Oregon 97504  
(503) 776-0991 • 474-7720

**11852**

SURVEY NO.-----

**SURVEY FOR:** Boise Cascade Corporation  
P.O. BOX 100  
Medford, Oregon 97501

**LOCATION:** Section 36, Township 38 South, Range 2 West  
Willamette Meridian, Jackson County, Oregon.

**PURPOSE:** To monument the Northeast 1/16 Corner and the  
East 1/16 corner between Sections 25 & 36.  
Also, to mark the lines as shown on  
accompanying plat.

**DATE:** December, 1989

**BASIS OF  
BEARING:** Bearings based upon Recorded Survey number  
7877.

**PROCEDURE:** Utilizing a Wild T-2, Wild T-16 theodolites and  
Mac 1E EDM, I tied the Northeast and Northwest  
Section corners, N 1/4, W 1/4, C 1/4 and CN  
1/16 corner. With these corner ties and the use  
of Recorded Survey number 7877, I computed the  
position for the East 1/16 corner:

which I monumented with a 5/8"x 30" re-bar,  
with a yellow plastic cap marked "TEMPLIN  
2359", from which;

A 12" Madrone, bears S44°16'W, 22.80 feet,  
scribed " E1/16S36" "BT".

A 12" Black Oak, bears N13°26'W, 23.70 feet,  
scribed " E1/16S25" "BT".

I then ran from the Center North 1/16 corner to  
the Northeast 1/16 corner:

which I monumented with a 5/8"x 30" re-bar,  
with a yellow plastic cap marked "TEMPLIN  
2359", from which;