

LEGEND:

- FOUND MONUMENT AS NOTED, MARKING A CORNER OF THE ORIGINAL GOV'T SURVEY.
- FOUND 1" BRASS DISK MARKED FRIAR PLS 961.
- FOUND 5/8" I. PIN W/ PLASTIC CAP MKD. FRIAR PLS 961.
- FOUND 5/8" I. PIN W/ PLASTIC CAP MKD. SWAN PLS 759.
- SET 5/8" I. PIN W/ PLASTIC CAP MKD. FRIAR PLS 961.
- SET PYK NAIL W/ BRASS TAG MKD. FRIAR PLS 961 IN ROCK.
- CALCULATED POINT. NOTHING FOUND OR SET.

REGISTERED
**PROFESSIONAL
 LAND SURVEYOR**
Larry J. Friar
 OREGON
 JULY 16, 1971
 LARRY J. FRIAR
 561

RECEIVED
 SURVEYOR

MAP OF SURVEY
 FOR
JACKSON COUNTY DEPT. OF PARKS & RECREATION
 LOCATED IN DONATION LAND CLAIM NO. 48 & THE E. 1/2 OF SEC. 31, T. 38 S., R. 1 E., W.M. JACKSON COUNTY OREGON
 DATE: JANUARY 5, 1990
 BASIS OF BEARINGS: SURVEY NO. 10704.
 SURVEY BY: L.J. FRIAR & ASSOCIATES, P.C., MEDFORD, OREGON
 SCALE: 1"=200'

38S, 1E, S.31 T/L 500

Survey No. 11875

Survey Narrative To Comply With O.R.S. 209.250

Survey For: Jackson County Parks and Recreation
Jackson County Courthouse
Medford, Oregon 97501

Location: Donation Land Claim No. 48 and the E. 1/2 of
Sec. 31, T.38 S., R.1 E., W.M., Jackson County,
Oregon.


Purpose: To survey and monument the Southerly right-of-way
of a proposed section of the Bear Creek Greenway
Bike Path lying outside the Southerly right-of-way
of Eagle Mill-Antelope Road to be purchased by
Jackson County, and to remonument a portion of the
centerline of the Bike Path as shown on Survey No.
10704.

Procedure: Recovered monuments and control established by
this office during Survey No. 10704. Tied in
proposed centerline points set by Parks and
Recreation personnel and calculated the Southerly
right-of-way. Given new curve data supplied by the
Parks and Recreation Department, reset the pins in
the new centerline location. Monuments found, set
or removed are as shown on the annexed map.

Basis of Bearing: Survey No. 10704.

Date: January 5, 1990

T38S R1E SEC31 TL500

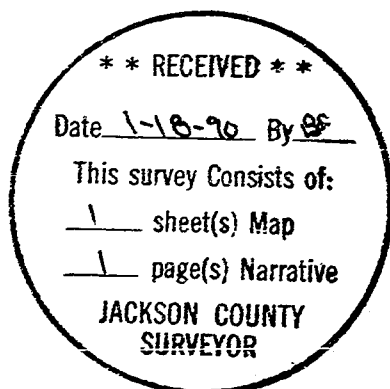

Larry J. Friar
L.J. Friar & Associates P.C.
Consulting Land Surveyors
717 West 10th, Suite 1
Medford, OR 97501
(503) 772-2782

