

4 0611

MAP OF SURVEY FOR

1190

T.J. HIGHT. MEDFORD, OREGON
IN SECTION 20, T.37S. R.2W. W.M. JACKSON CO. OREGON.

DATE: 11-29-58

SCALE: 1" = 100'

NW COR. SW NW

DATUM: SOLAR BN.

3/4 I.P.


1" I.P.

N. LINE SW 1/4 - NW 1/4. N. 89° 41' 55" E. 535.86'

N. 0° 11' 45" E. 1925.20'

1" I.P.

W 1/4 COR.

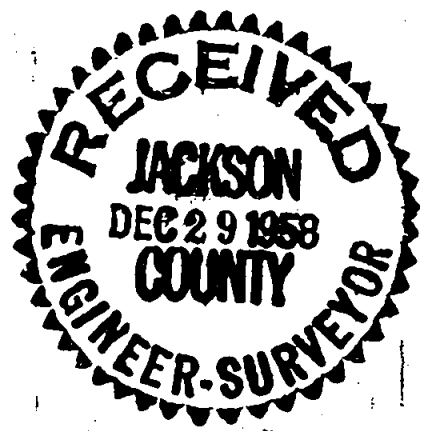

REGISTERED
OREGON
LAND SURVEYOR

L. E. Ager

MARCH 18, 1944
L. E. AGER
21

N. 53° 53' 30" N. 613.06'

N. 38° 15' W. 701.0'

S. 2° 09' E. 1784.55'

1/2 I.P.

N. 47° 45' W. 159.88'

1" I.P.
S. 42° 15' W. 418'

3/4 I.P.

N. 47° 45' W. 152.99'

3/4 I.P.

3/4 I.P.

SPRING

S. 46° 40' 10" N. 316.54'

1/2 I.P.

S. 57° 34' E. 348.86'

N. 31° 57' 30" E. 260.31'

1190

Survey narrative to comply with Section 87-330, Oregon State Law of 1947

For: T. J. Hight, Medford, Oregon

Purpose: To establish the corners and describe tracts of land shown on accompanying map and tie the center of a Spring to the West Quarter corner of the Section shown by bearing and distance.

Procedure: The corners of the tract had been previously established and marked with iron pipes by McGinty except the northeast corner, which I established by bringing the Easterly line to an intersection with the Northerly line of the tract. The northerly line of this tract was marked with iron pipes, one set at the northwest corner and one southeasterly beyond the northeast corner of tract shown on map. From the northwest corner of this tract I made a direct tie to the West Quarter corner and also from this corner I tied in the Spring by bearing and distance. Other lines appearing on this map beyond the limits of this survey were copied from McGintys map of his survey. Iron pipes placed at all corners as indicated on accompanying map.

